


T.14S.,R.9W.,W.M.

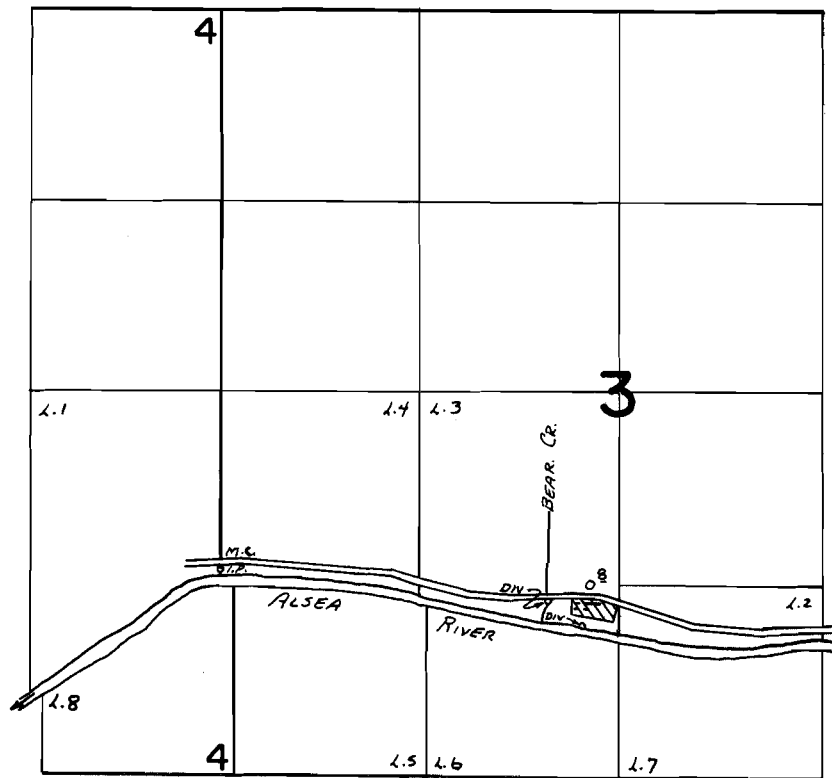

BEAR CR. - DIV. PT. - 230' S AND 2260' E } FROM M.C. AT SW COR Lot 4  
ALSEA Riv. - DIV. PT. - 400' S AND 2490' E } OF SEC 3

- - TRAILER SITE (TOTAL OF 3)
- - BEAR CREEK LODGE (4 UNITS)

### FINAL PROOF SURVEY UNDER

Application No. 48604 Permit No. 36463  
IN NAME OF

MARY JEAN WILSON

Surveyed SEPT. 12 1975, by L. Toll