


T.10S.,R.9W.,W.M.

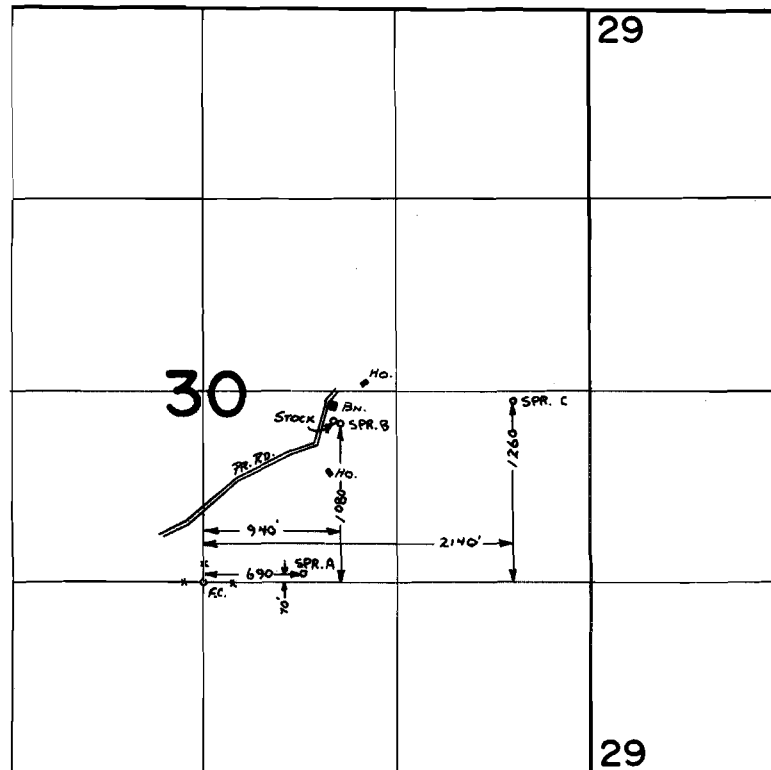

FINAL PROOF SURVEY

UNDER

Application No. 50002 Permit No. 37602
IN NAME OF

M. FAXON & SONS

Surveyed SEPT. 24 1975, by L. Toll.....