


T.12S., R.11W., W.M.

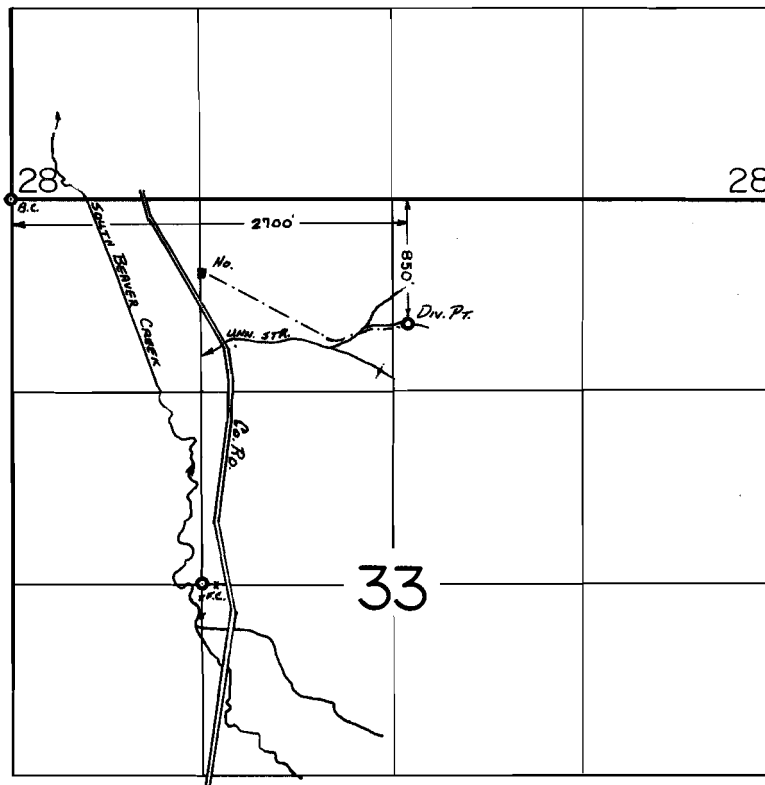

FINAL PROOF SURVEY
UNDER

Application No. 53189 Permit No. 38630
IN NAME OF

GLADYS MCCOY

Surveyed Sept. 23, 1975, by L. Tom