


Marion Forks Summer Ho
4/3/53

WATER TRANSMISSION

mission

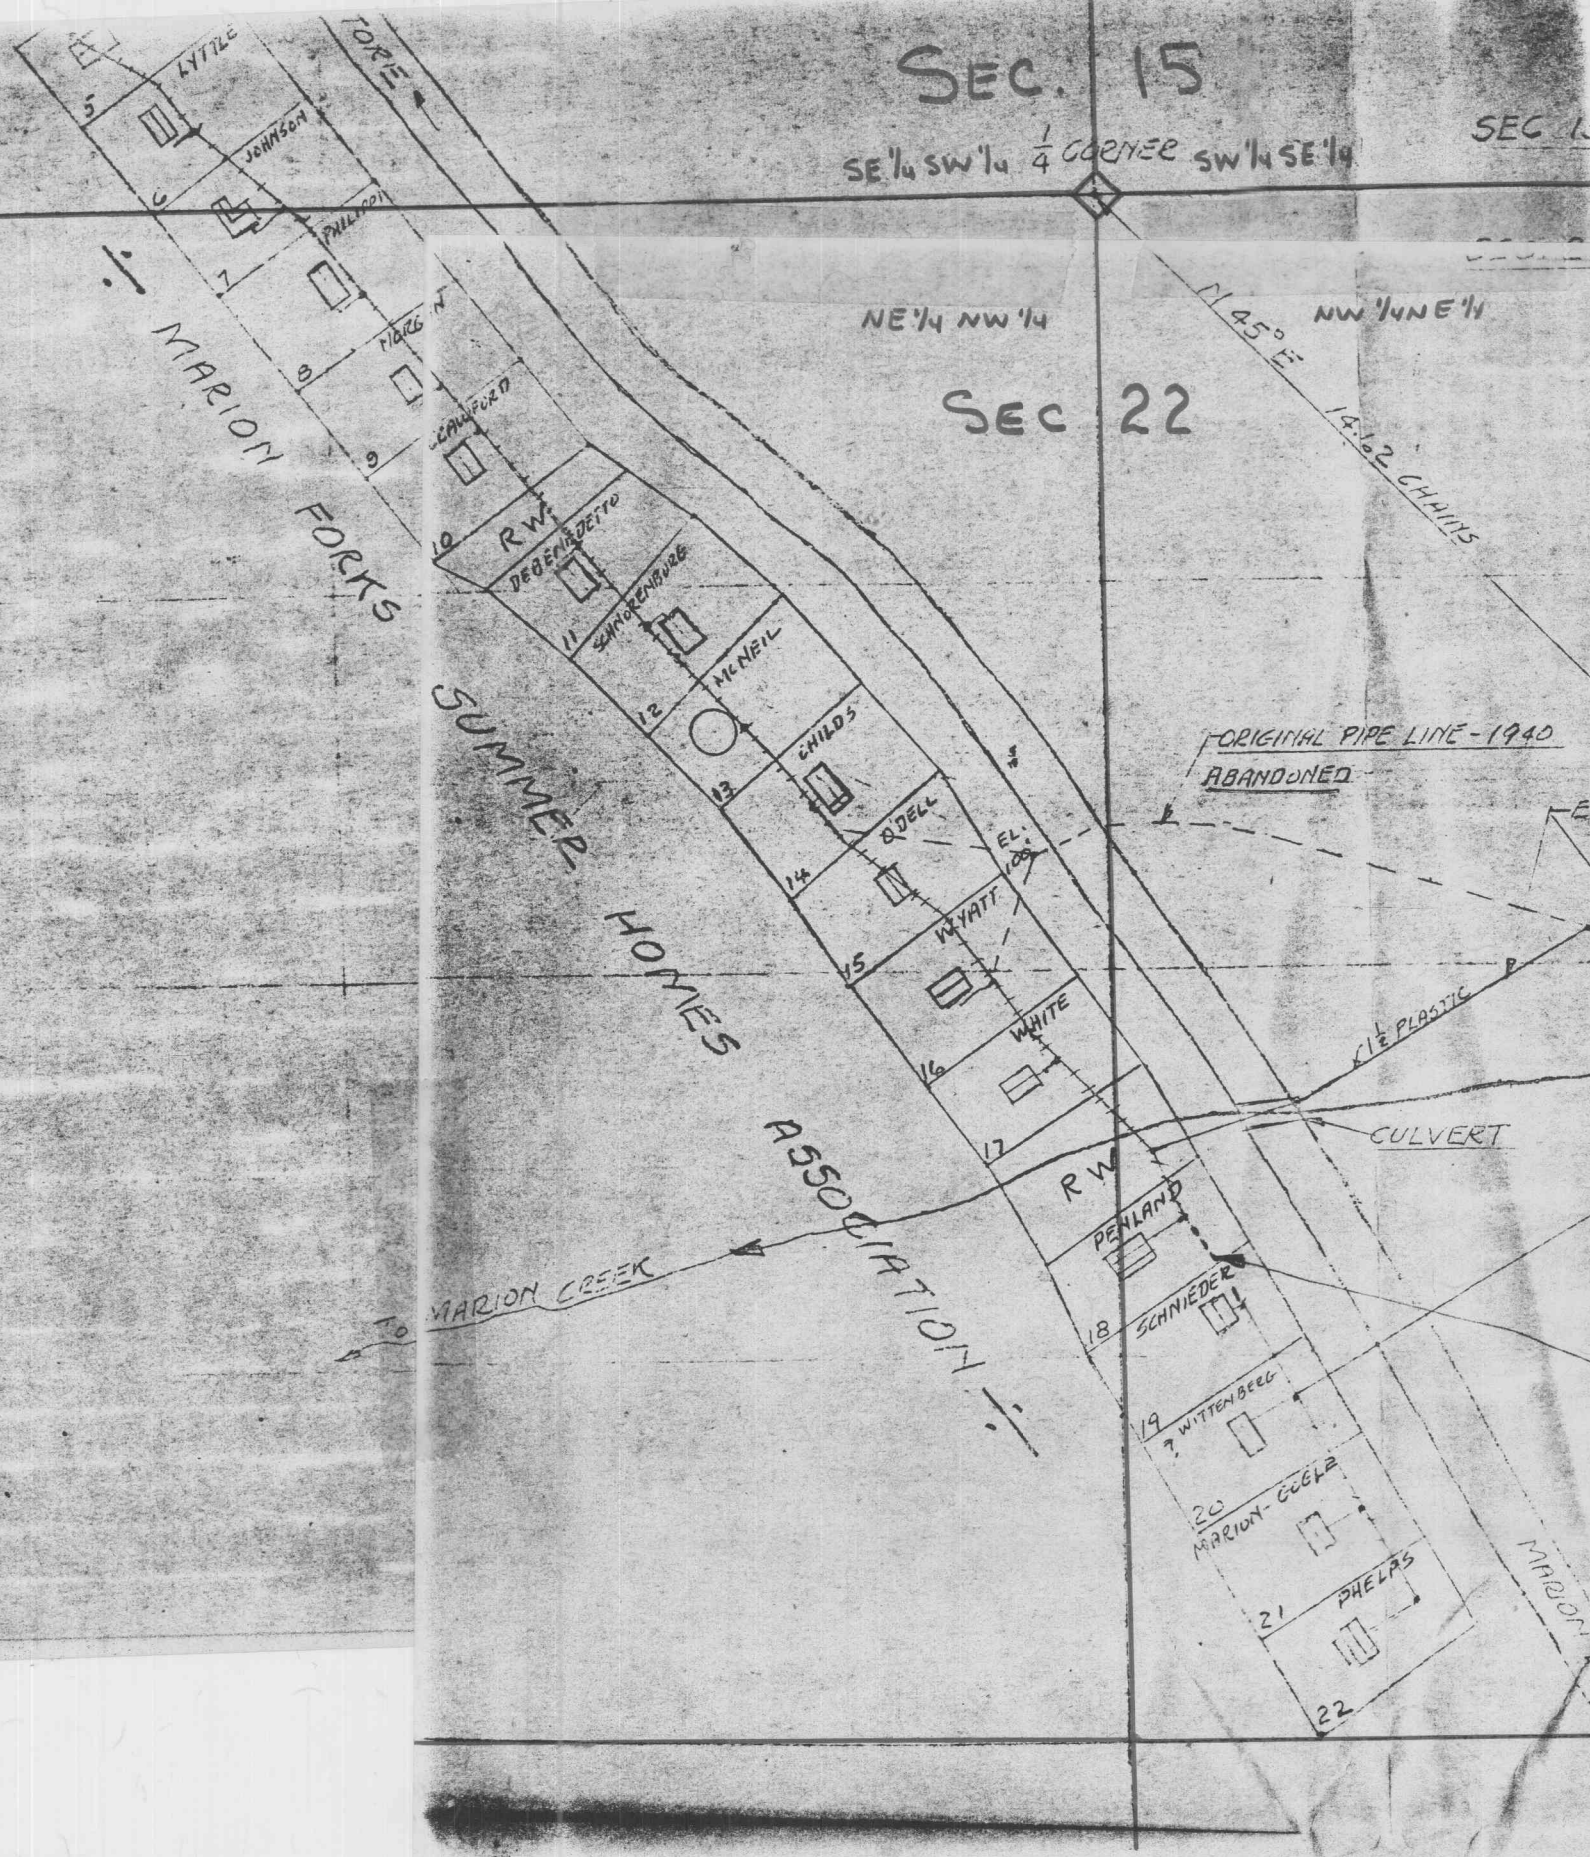

(McNEIL
8/30/69 BY O'DELL
STATE WATER RIGHT - 0.02 CFS.
2 CABINS ONLY
#20-22
PERMIT GRANTED 1952
DATE OF APPLICATION 1951

McNEIL'S RECOMMENDATION TO ABANDON EXISTING LINE BY VITTORE
AND TIE INTO MAIN SYSTEM BY CONNECTION BETWEEN
LOTS 18 AND 19

D.J. McNEIL
9-5-69

FINAL PROOF MAP