


T.I.S., R.I.E., W.M.

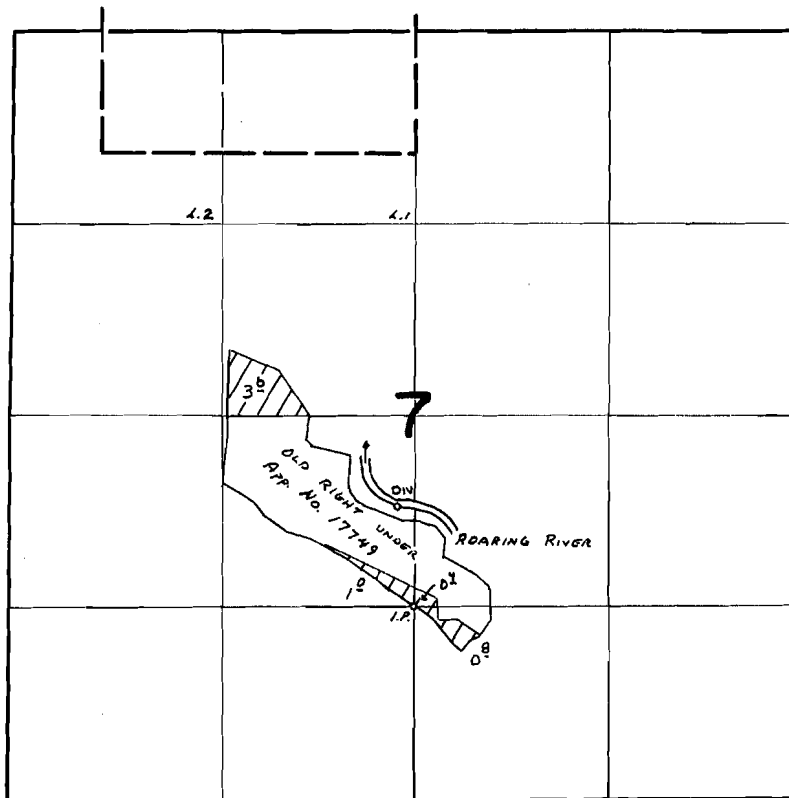

DIV. LOC: 2030' N AND 2740' W FROM SE COR SEC 7

FINAL PROOF SURVEY UNDER

Application No. 48292 Permit No. 35248
IN NAME OF

GEORGE S. & DORIS M. SEBITS

Surveyed APRIL 21 1975, by L. Toll