


T.29S., R.46E., W.M.

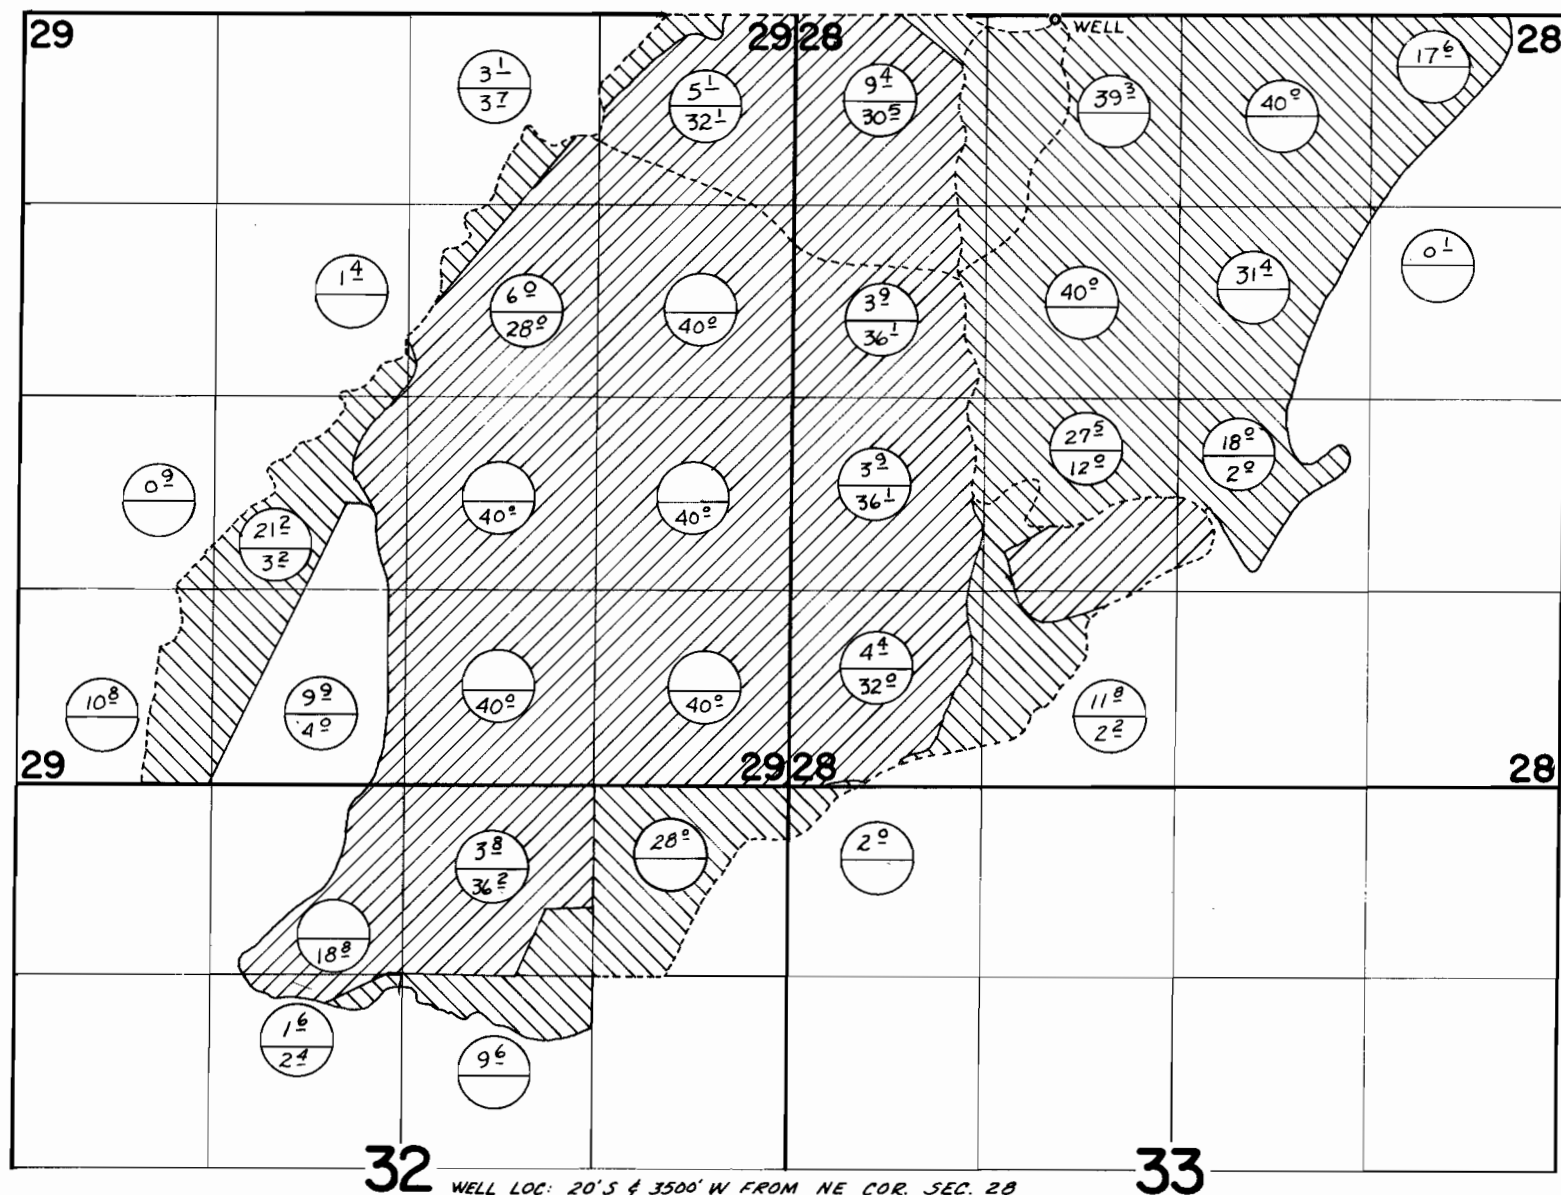

FINAL PROOF SURVEY UNDER

Application No. G-3623 Permit No. G-3406
IN NAME OF

WILLIAM AND FLORENCE ROSS

Surveyed: July 16, 1975, by: D. Norby