


T.9S. R.2W. W.M.

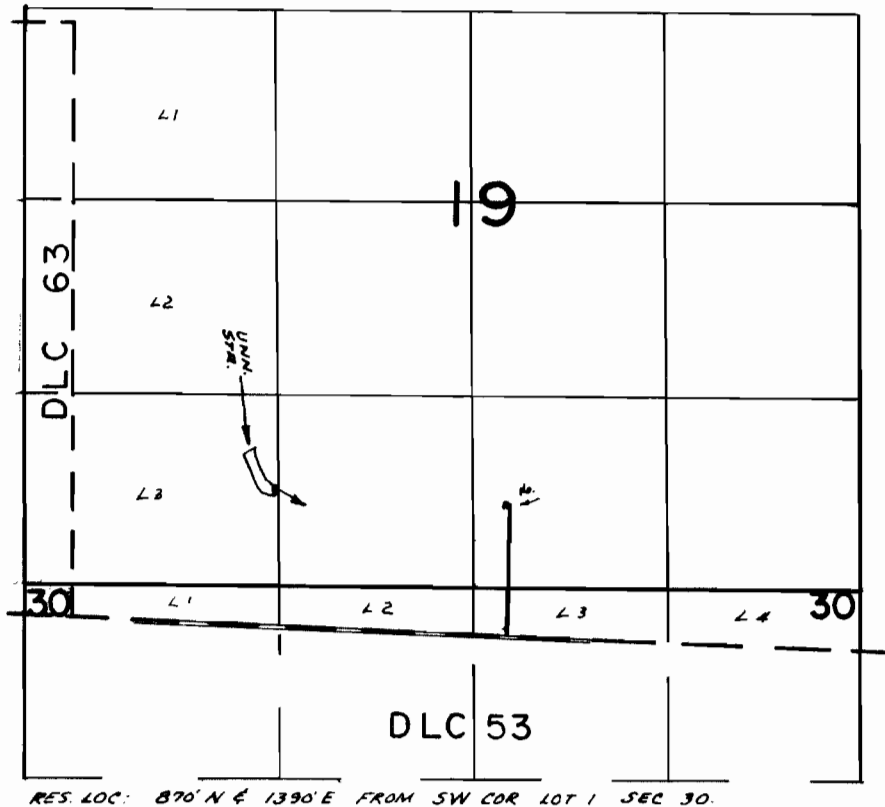

FINAL PROOF SURVEY
UNDER

R-46536 R-5549
Application No. 46537 Permit No. 34768
IN NAME OF

BYRON SIMONSON

Surveyed July 3 1974, by L.H. Nunn
May 27 1975 D.M. Norby