


T.9S. R.2W. W.M.

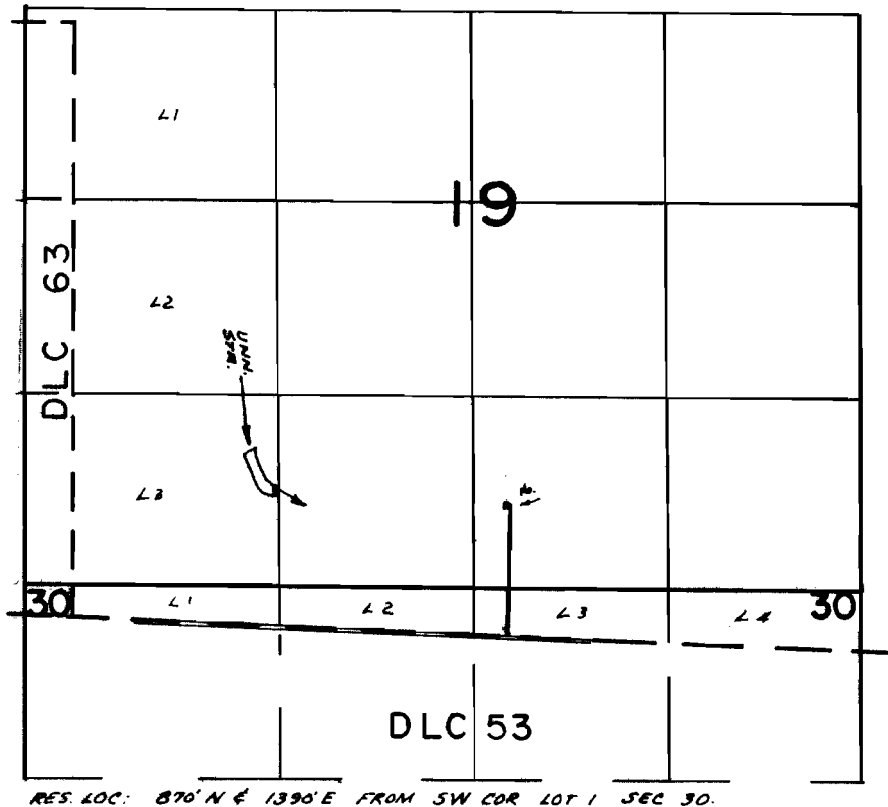

RES. LOC: 870' N & 1390' E FROM SW COR LOT 1 SEC 30.

FINAL PROOF SURVEY
UNDER

Application No. R-46536 46537 Permit No. R-5549 34768
IN NAME OF

BYRON SIMONSON

Surveyed July 3 1974 by L.H. Nunn
May 27 1975 D.M. Norby