


# T. 1 S. R. 3 E. W. M.

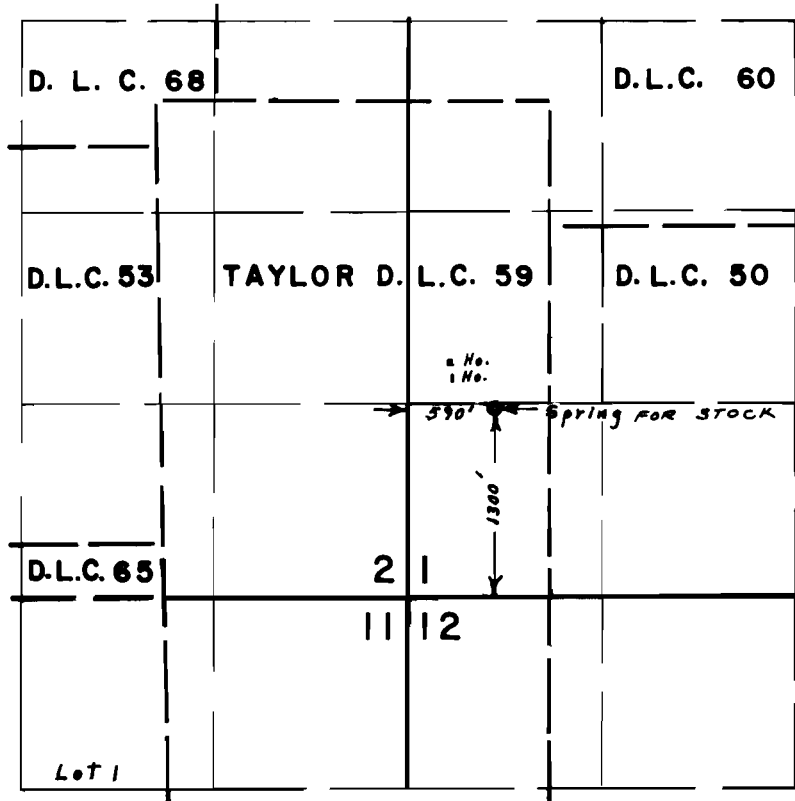

## FINAL PROOF SURVEY UNDER

Application No. 51153 Permit No. 38662  
IN NAME OF

MR. & MRS. JAMES E. LANCASTER

Surveyed Oct. 4, 1976, by L. E. Gould.