


T.6S. R.5W. W.M.

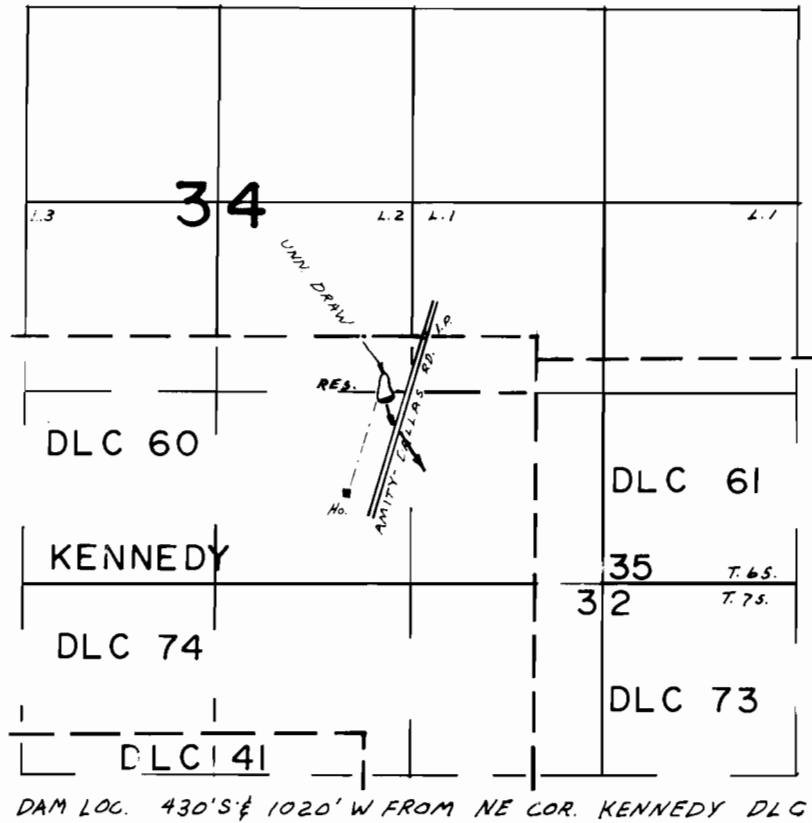

FINAL PROOF SURVEY UNDER

R-47286 R-5696
 Application No. 47287 Permit No. 35431
 IN NAME OF

HARLEY DAVISON

Surveyed APR. 15, 1975, by L.H. NUNN