


T.8S. R.5W. W.M.

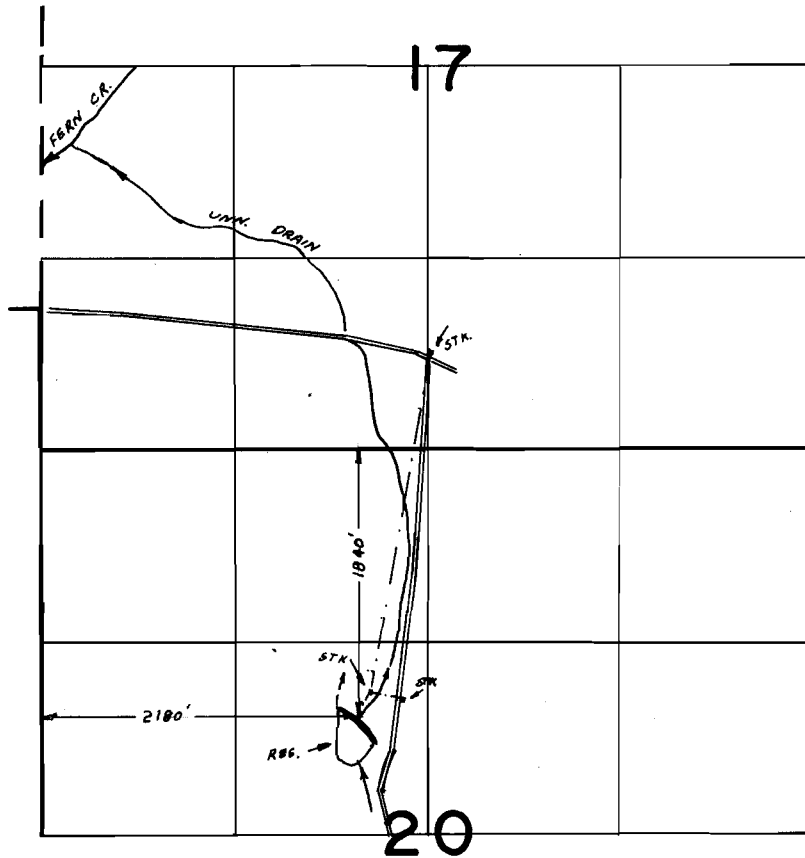

FINAL PROOF SURVEY
UNDER

R-48750 R-5913
Application No. 48751 Permit No. 36559
IN NAME OF

T. C. FISHER

Surveyed JUL 15 1974, by L.H. NUNN