


T.6S. R.3W. W.M.

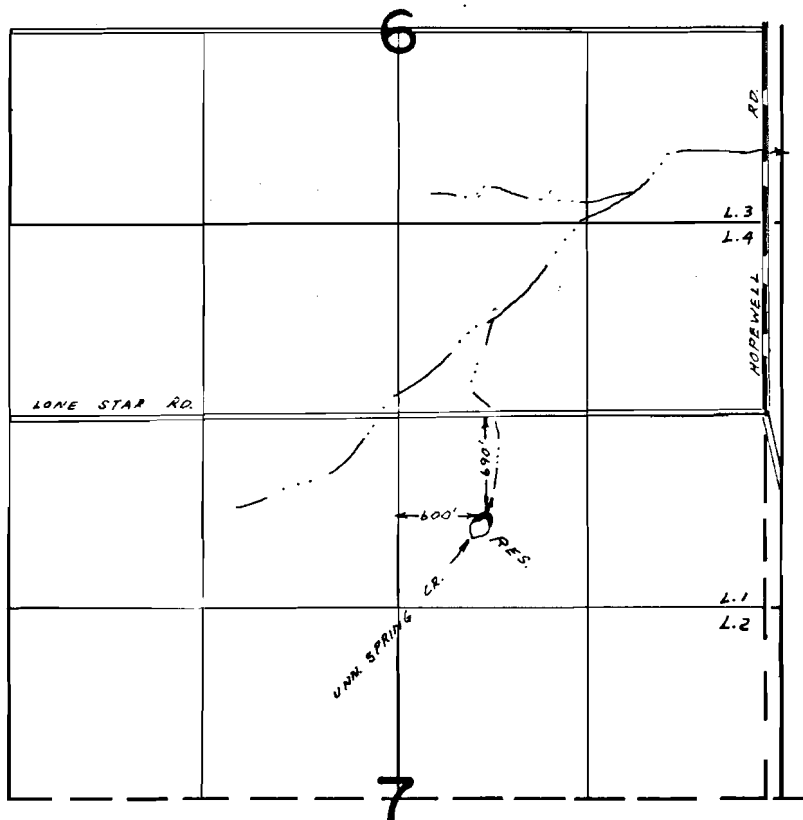

FINAL PROOF SURVEY
UNDER

R-49287 R-5820
Application No. 49288 Permit No. 35974
IN NAME OF

JOHN A. GOFFRIER

Surveyed OCT. 16, 1975, by L.H. NUNN