


G 3884

45327

T.5S. R.31E. W.M.

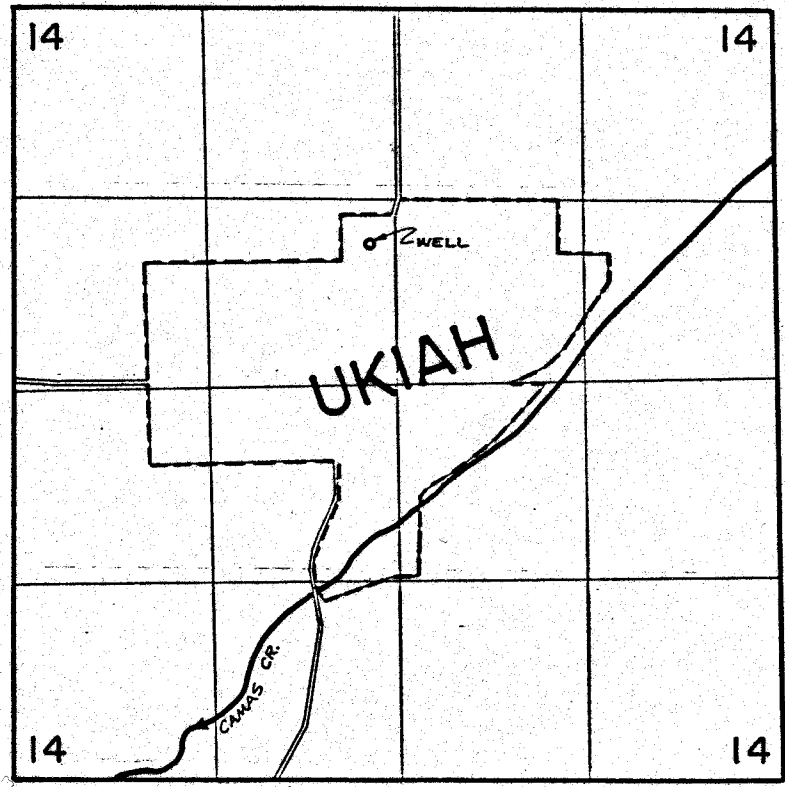

WELL LOCATED; 960' N. / 180' W. FROM CENTER SECTION 14

FINAL PROOF SURVEY UNDER

Application No. G.4132 Permit No. G.3884
IN NAME OF

Ukiah Water Association

Surveyed May 8 1975, by D. NORBY