


T.2N.,R.32E.,W.M.

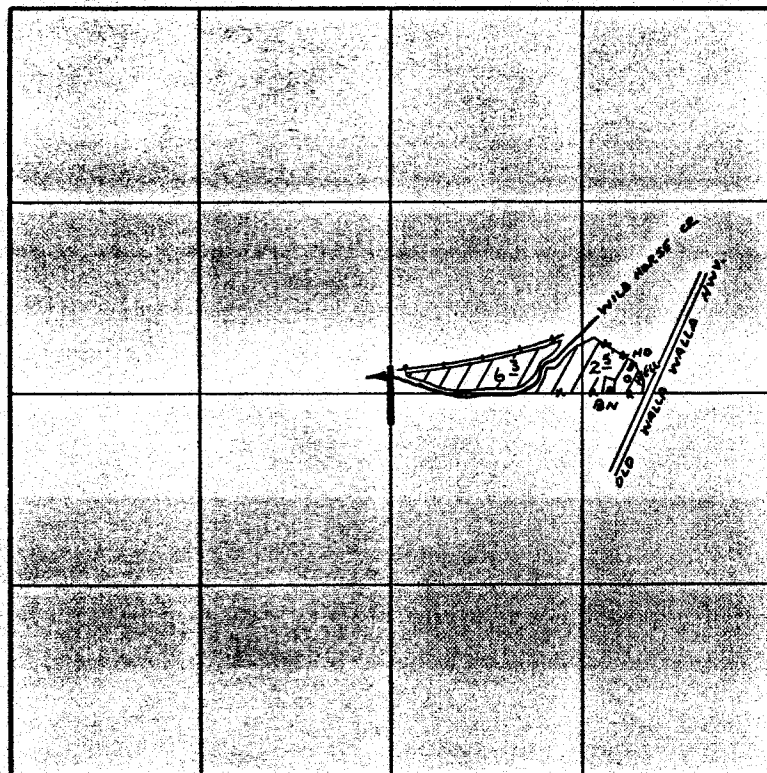

WELL LOC: 90' N & 1000' W FROM E 1/4 SEC 1

FINAL PROOF SURVEY
UNDER

Application No. G-4493 Permit No. G-4235
IN NAME OF

JOSEPH R. & SHARRIL MARCHBANKS

Surveyed April 5 1975, by L. Tall