


T.2N.,R.35E.,W.M.

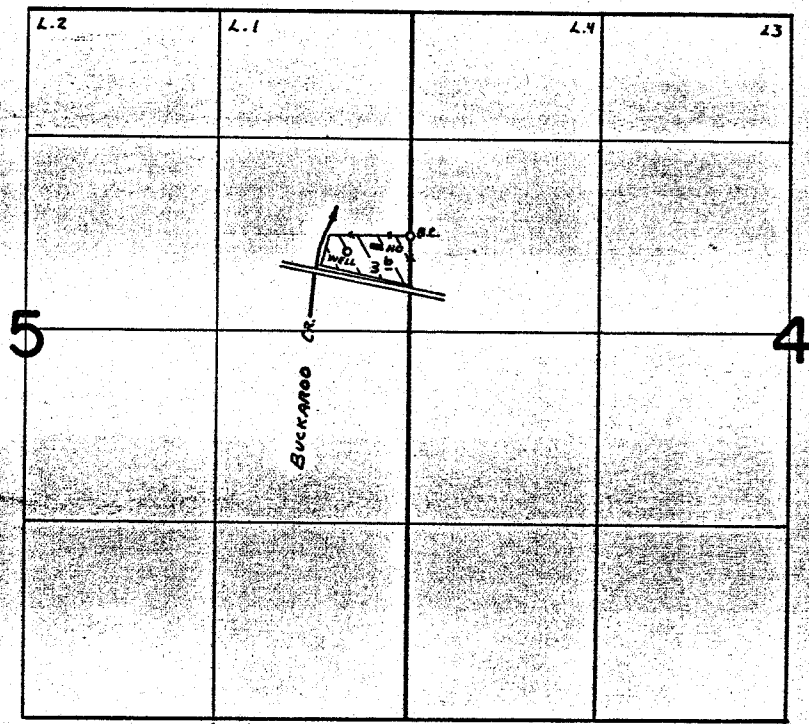

FINAL PROOF SURVEY UNDER

Application No. G-5154 Permit No. G-4886
IN NAME OF

DONALD A. & KATHERINE F. DAVIS

Surveyed APRIL 4 1975, by L. Toll