


T.I.S. R.38E. W.M

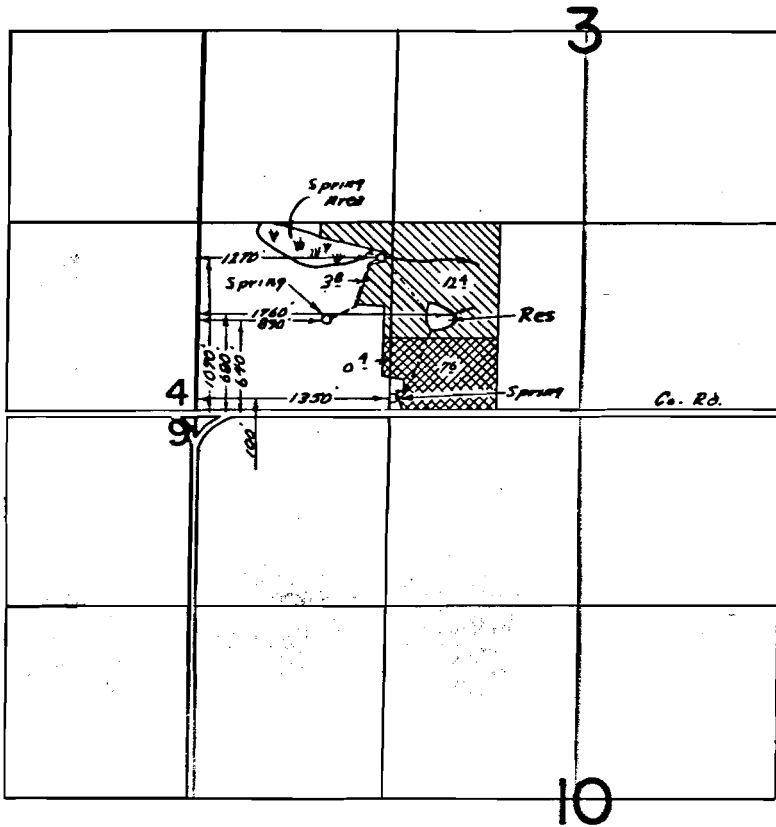

FINAL PROOF SURVEY

UNDER

Application No. 45541 45660 46687 Permit No. R-5382 33996 34074 IN NAME OF _____

GARY WEBSTER

Surveyed July 12 1973, by R.G. Mucken...