


T.I.S. R.38E. W.M.

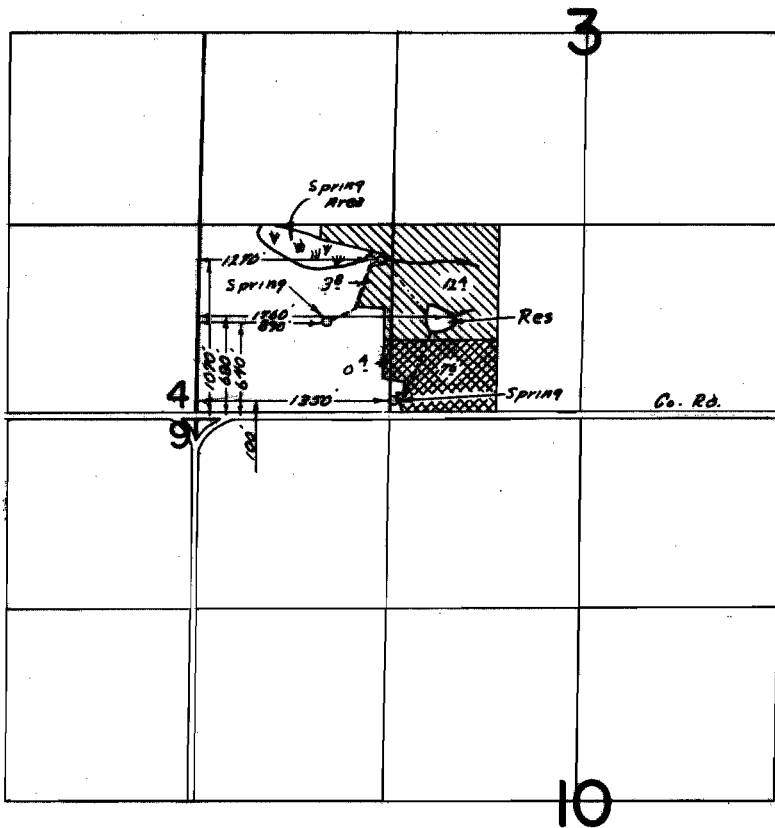

FINAL PROOF SURVEY

UNDER

Application No. R-45541
45660
16687 Permit No. R-5382
33996
34874

IN NAME OF

GARY WEBSTER

Surveyed July 12 1973, by R.G. Mucken