


T.1S. R.38E. W.M.

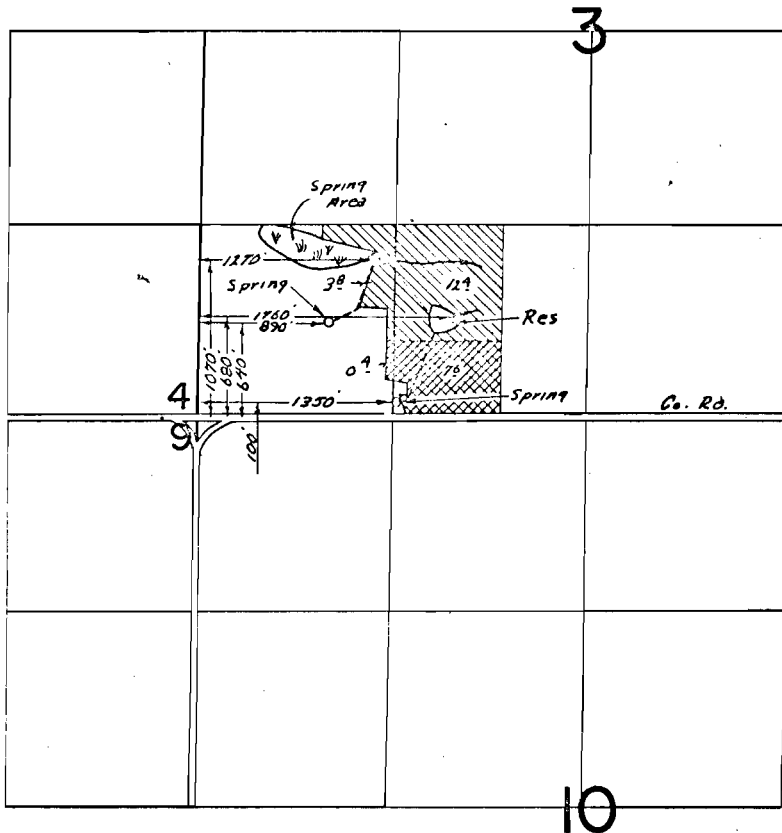

FINAL PROOF SURVEY
UNDER

Application No. R-45541
45660 Permit No. R-5382
46687 33996
IN NAME OF 24874

Surveyed July 12 1973, by R.C. Mucken