


T.1 S. R.39 E. W.M.

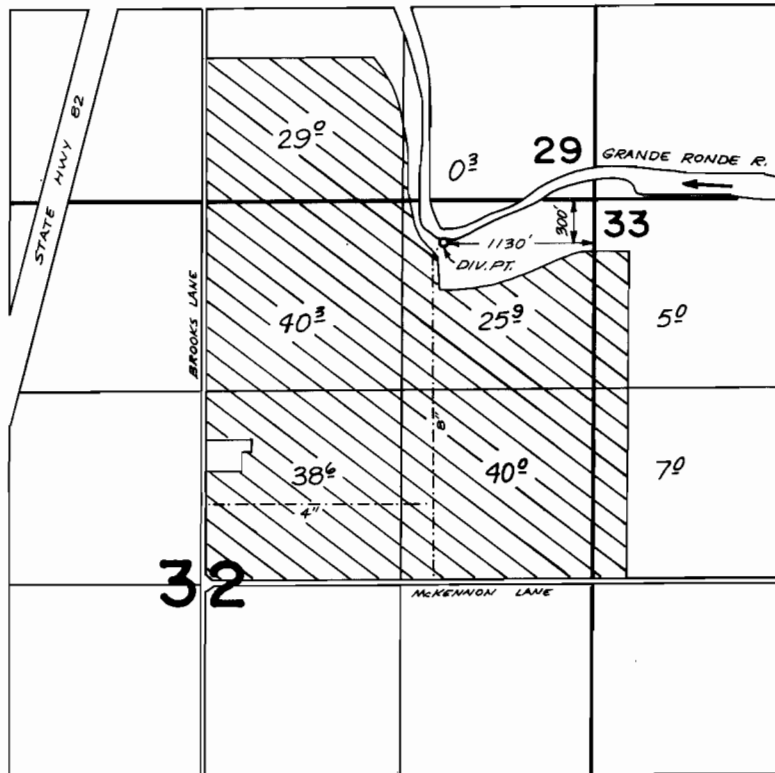

FINAL PROOF SURVEY UNDER

Application No. 47657 Permit No. 35659
IN NAME OF

Elwyn Bingaman

Surveyed April 4 1975, by D. Norby