


T.2S. R.38E. W.M.

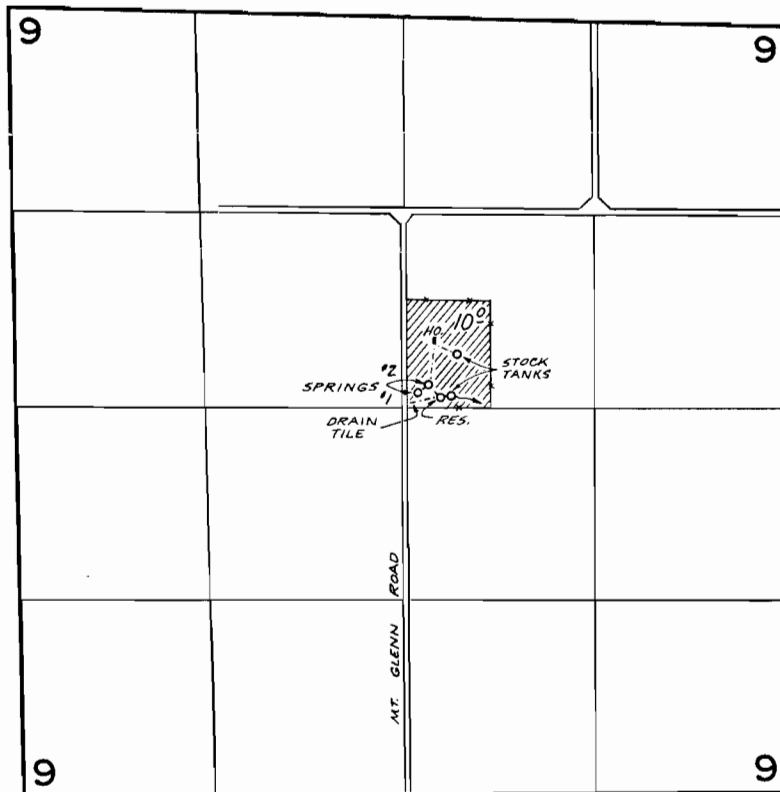

Res. - 80' N & 280' E
Spring No. 1 - 100' N & 90' E
Spring No. 2 - 160' N & 170' E } all from the C/4 Sec 9

FINAL PROOF SURVEY
UNDER

R 49718 R 6043
Application No. 49882 Permit No. 37271
IN NAME OF

Perry H. Price Sr.

Surveyed April 9, 1975, by D. NORBY