


T.2S.R.45E.W.M.

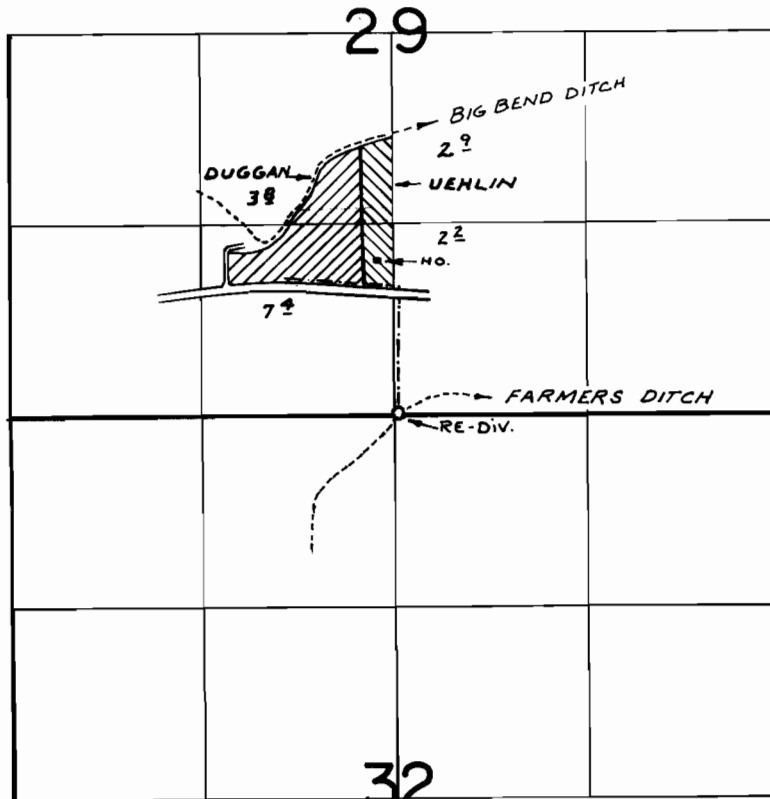

DIV. LOC: S. 77° 20' E. 624' FROM N.W. COR. SEC. 5, T. 35. R. 45E. WM

FINAL PROOF SURVEY
UNDER

Application No. 51823 Permit No. 39027

IN NAME OF

Jack R. Duggan

Gail B. & Helen E. Uehlin

Surveyed SEPT. 28 1977, by R. MUCKEN