



T.1N.,R.12E.,W.M.

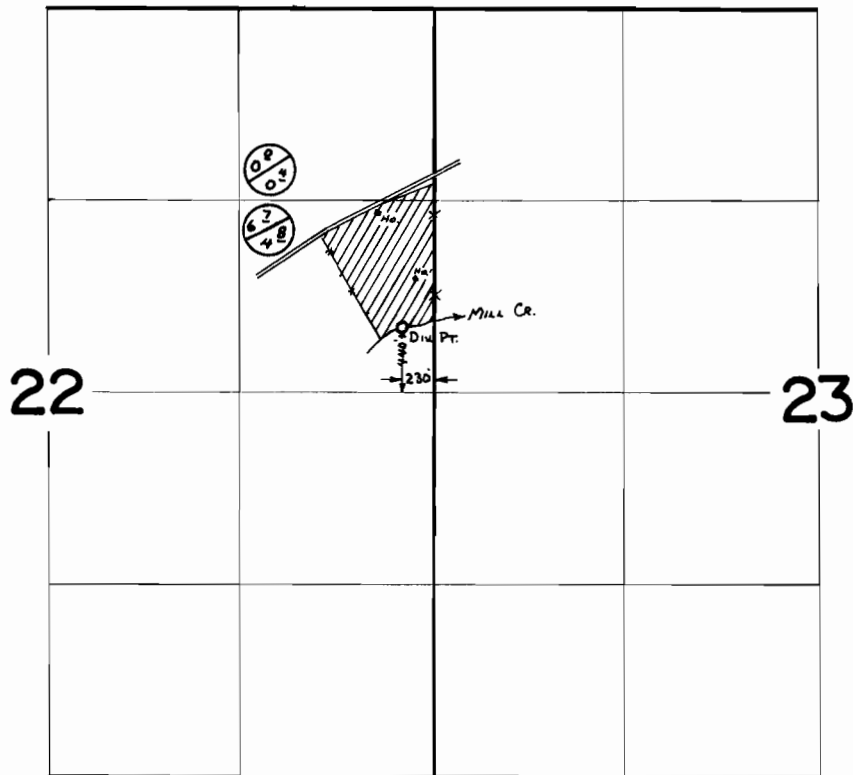

 A.- PERMIT 35947 ACREAGE
B.- CERT. 5706 ACREAGE

FINAL PROOF SURVEY
UNDER

Transfer No. **2485**
Application No. **47945** Permit No. **35947**
IN NAME OF

MELVIN C. DOYLE

Surveyed APRIL 26, 1974, by D. NORBY
APRIL 6, 1976 R.G. Mucken