


# TIS., R.3W., W.M.

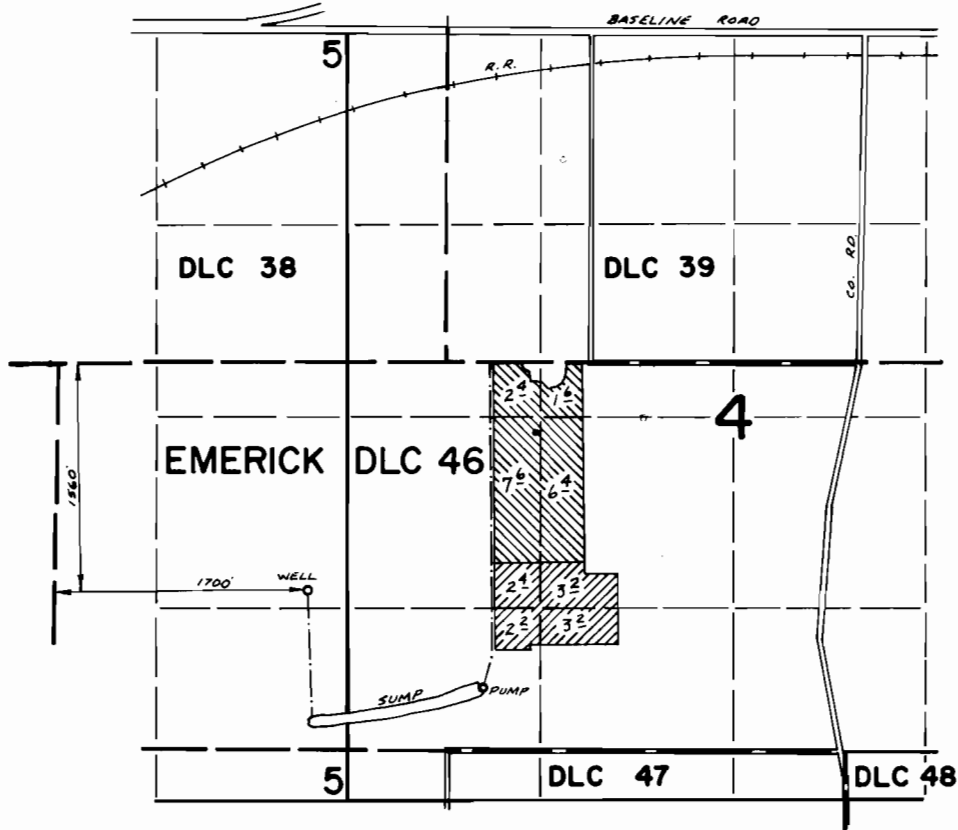

## FINAL PROOF SURVEY UNDER

Application No. G-5474 Permit No. G-5381  
IN NAME OF

MELVIN J. FINEGAN

Surveyed Oct. 8 1975, by D. Norby