


45349  
45350

# T.7&8S.R.23E.W.M.

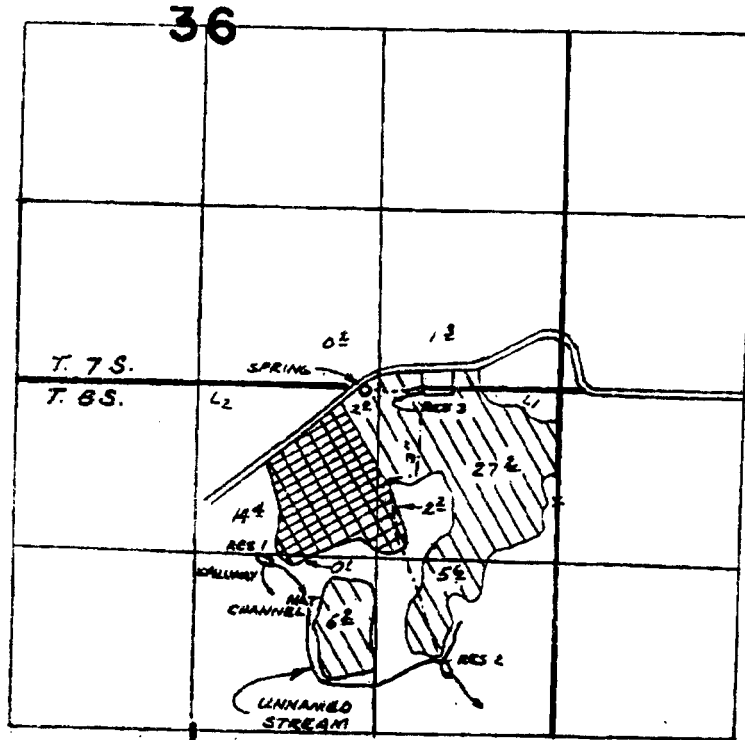

DIV. PTS. LOC: RES. #3-50'S. E 1050'W; SPRING-1430'W; RES. #1  
 1300'S. E 2100'W; RES. #2-2100'S. E 750'W; ALL FROM N.E. COR. SEC. 1  
 IRRIGATED FROM PONDS 2 & 3



IRRIGATED FROM PONDS 1, 2, & 3

## FINAL PROOF SURVEY UNDER

R49930 R 6081  
 Application No. 49827 Permit No. 37424  
 IN NAME OF

**ARTHUR W. BOLSTER**

Surveyed AUG. 27. 1977, by R. BARWIN.....