


45349
45350

T.7&8S.R.23E.W.M.

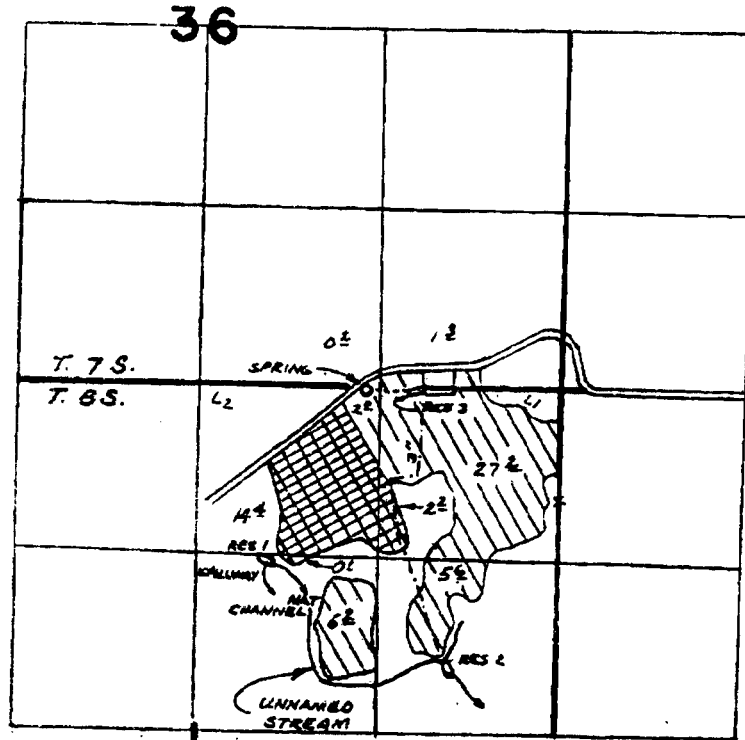

DIV. PTS. LOC: RES. #3-50'S. E 1050'W; SPRING-1830'W; RES. #1
 1300'S. E 2100'W; RES. #2-2100'S. E 750'W, ALL FROM N.E. COR. SEC. 1



IRRIGATED FROM PONDS 2 & 3



IRRIGATED FROM PONDS 1, 2, & 3

FINAL PROOF SURVEY UNDER

R49930

R 6081

Application No. 49827 Permit No. 37424

IN NAME OF

ARTHUR W. BOLSTER

Surveyed AUG. 27. 1977, by R. BARWIN.....