


38062
45351

T.8S., R.24&25E., W.M.

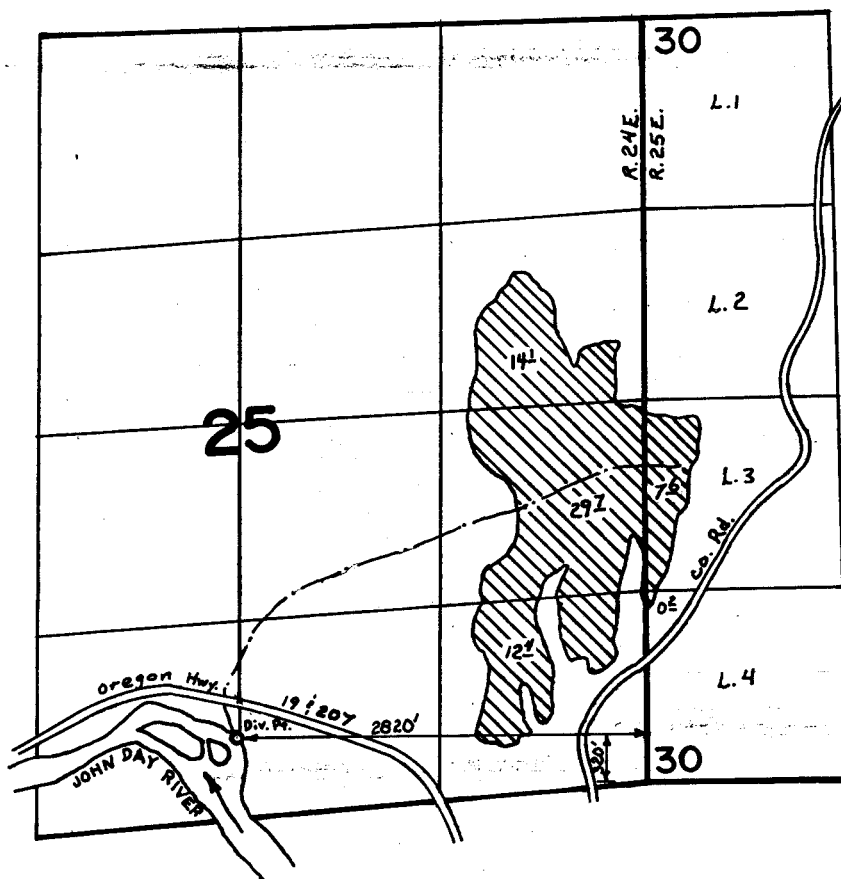

FINAL PROOF SURVEY
UNDER

Application No. 52130 Permit No. 38062
IN NAME OF

FRANK CECIL

Surveyed AUG. 21 1976, by D. NORBY