


RECEIVED

SEP 19 1994

WATER RESOURCES DEPT. SALEM, OREGON

T.8S.,R.42E.,WM.

- Supp  
- Primary

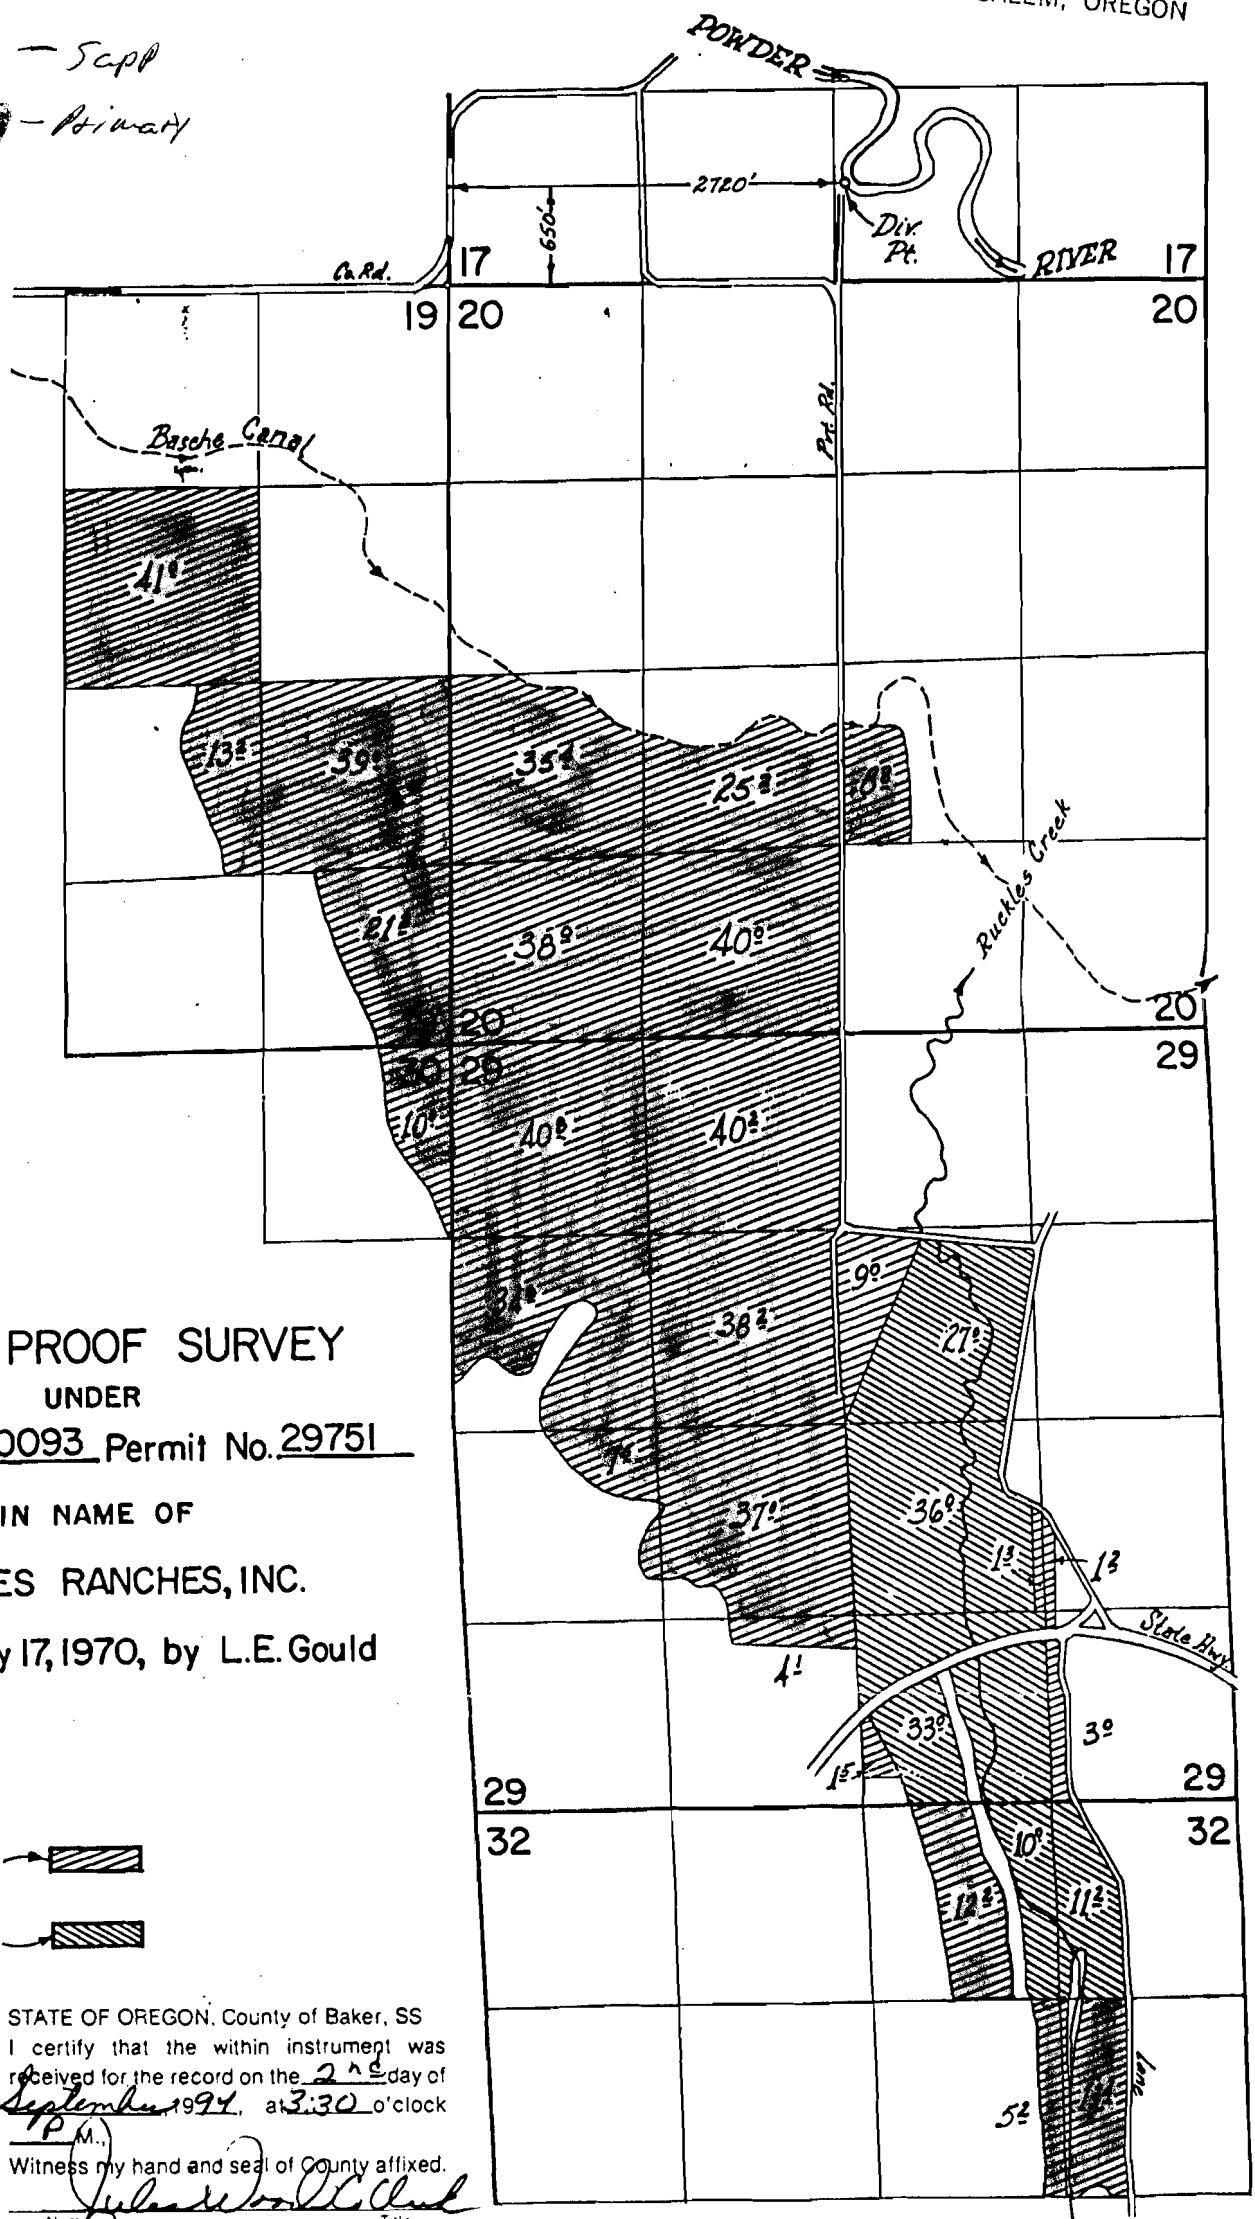

FINAL PROOF SURVEY UNDER

Appl. No. 40093 Permit No. 29751

IN NAME OF

DEVRIES RANCHES, INC.

Surveyed, July 17, 1970, by L.E. Gould

Primary

Supplemental

STATE OF OREGON, County of Baker, SS  
I certify that the within instrument was received for the record on the 2<sup>nd</sup> day of September, 1994, at 3:30 o'clock

Witness my hand and seal of County affixed.

20352

Name Julius D. Caldwell Title

By H. Morgan

Deputy