


T.14S. R.5W. W.M.

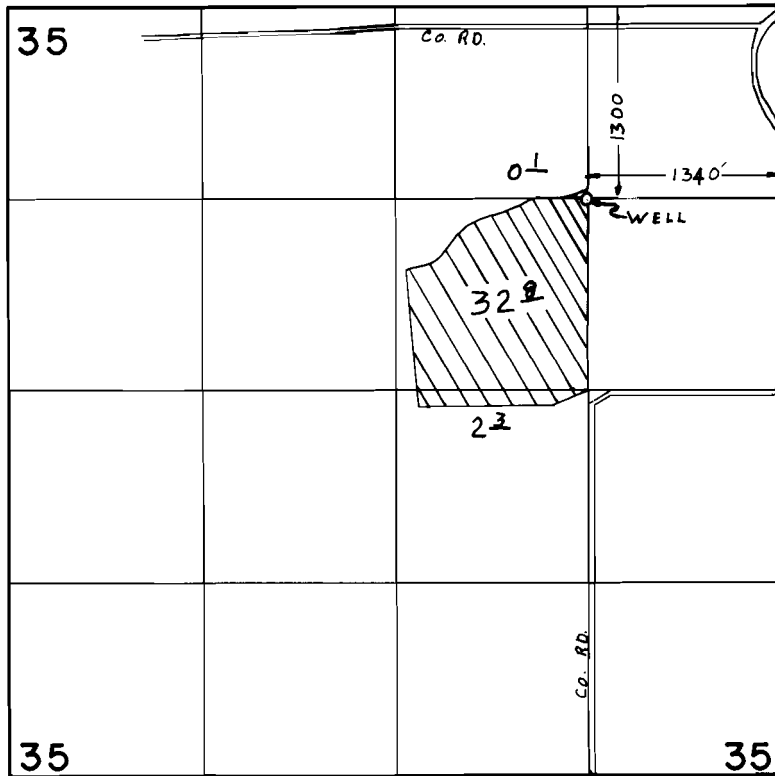

FINAL PROOF SURVEY
UNDER

Application No. G-5675 Permit No. G-5496

IN NAME OF
ESTATE OF

GEORGE K. LOWE

Surveyed APR 2 1976, by C.R. KING