


T.12S., R.5W., W.M.

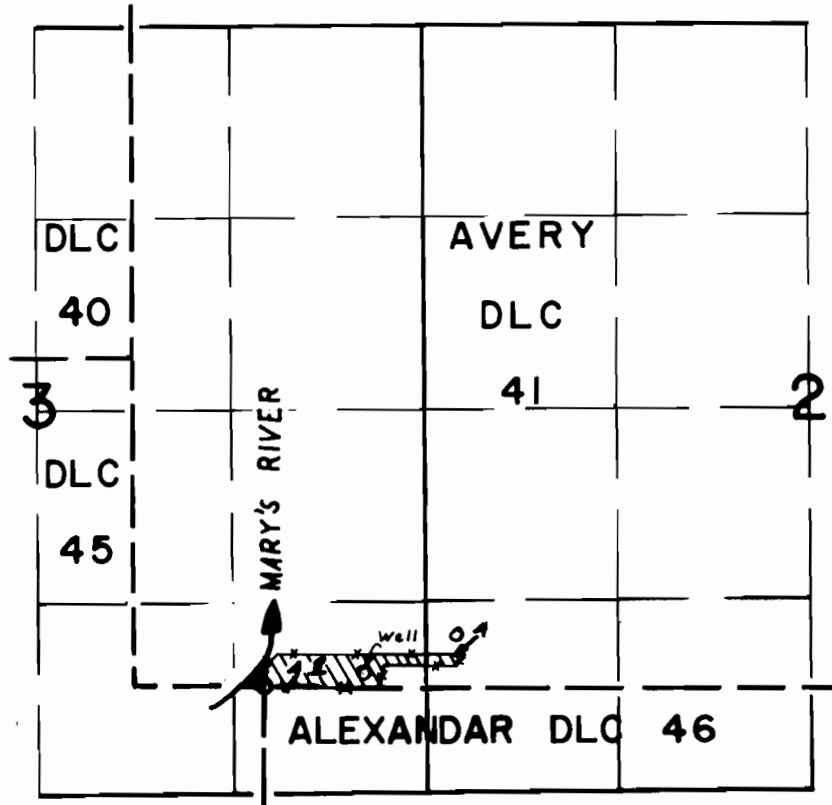

WELL: 90°N & 675'E FROM NW COR DLC 46

FINAL PROOF SURVEY
UNDER

Application No. G-6176 Permit No. G-5855
IN NAME OF

ARCHIE L. & ALMA U.T.T.

Surveyed MAR. 31. 1976, by C.R. KING.