


T.3 S. R.1 W. W.M.

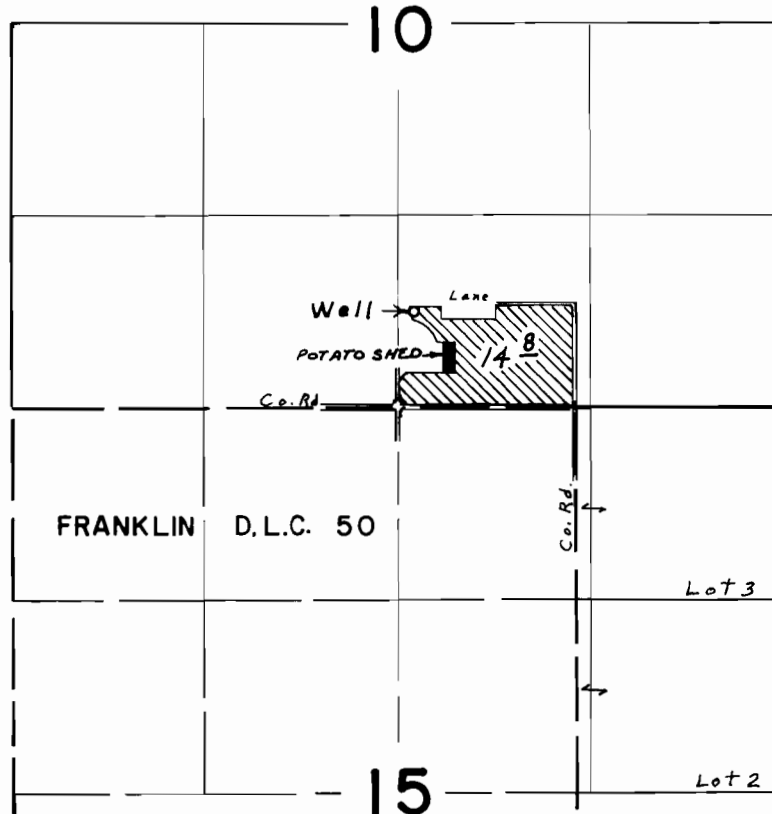

FINAL PROOF SURVEY
UNDER

Application No. G-5428 Permit No. G-5472
IN NAME OF

DONALD E. BISCHOF

Surveyed April 22, 1976, by L. E. Gould