


T.4 S. R.1 E. W.M.

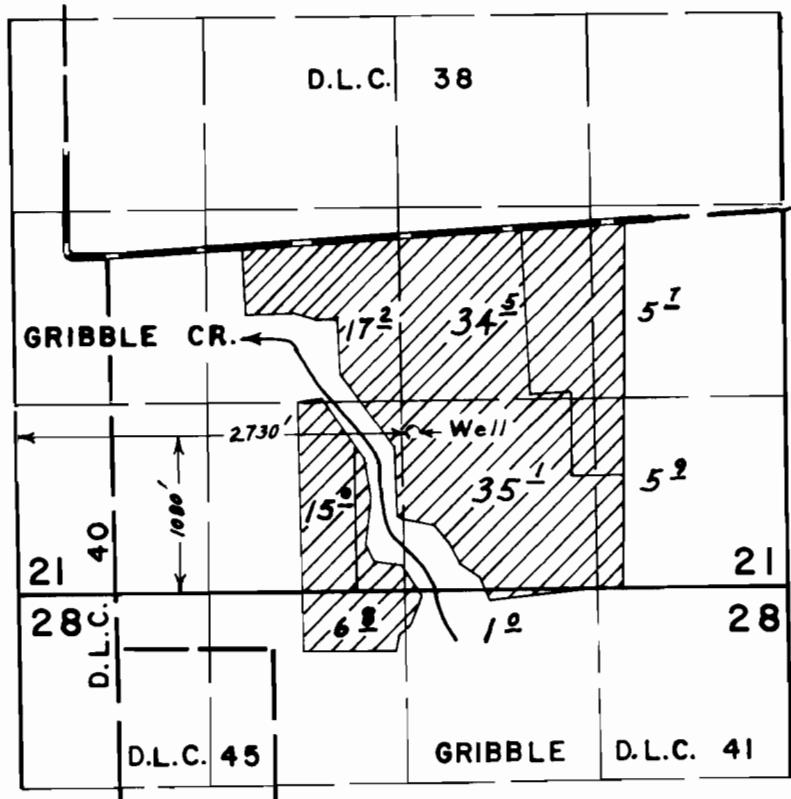

FINAL PROOF SURVEY UNDER

Application No. G-5550 Permit No. G-5427
IN NAME OF

FRANK LAIS

Surveyed July 6., 1976., by L. E. Gould.