


T.5 S. R.2 E. W. M.

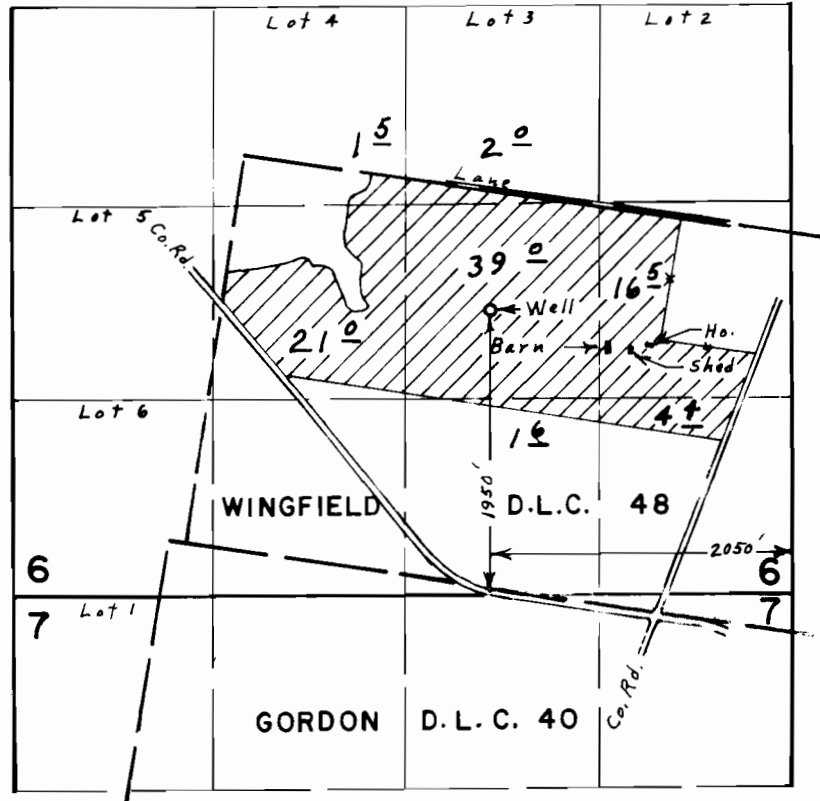

FINAL PROOF SURVEY UNDER

Application No. G-571.4 Permit No. G-5519.
IN NAME OF

RICHARD MOORHOUSE

Surveyed May 17, 1976, by L. E. Gould