


T.5 S. R.1 W.&1 E. W.M.

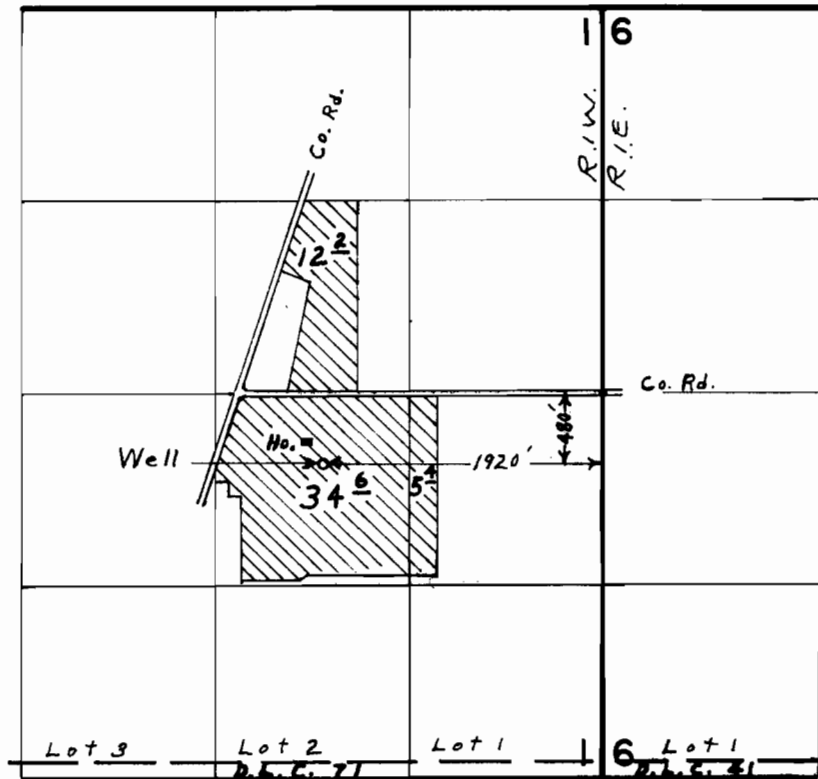

FINAL PROOF SURVEY

UNDER

Application No. G-5766 Permit No. G-5546

IN NAME OF

ED PARDEY

Surveyed June 18 1974, by L. E. Gould