


T.3 S. R.2 E. W.M.

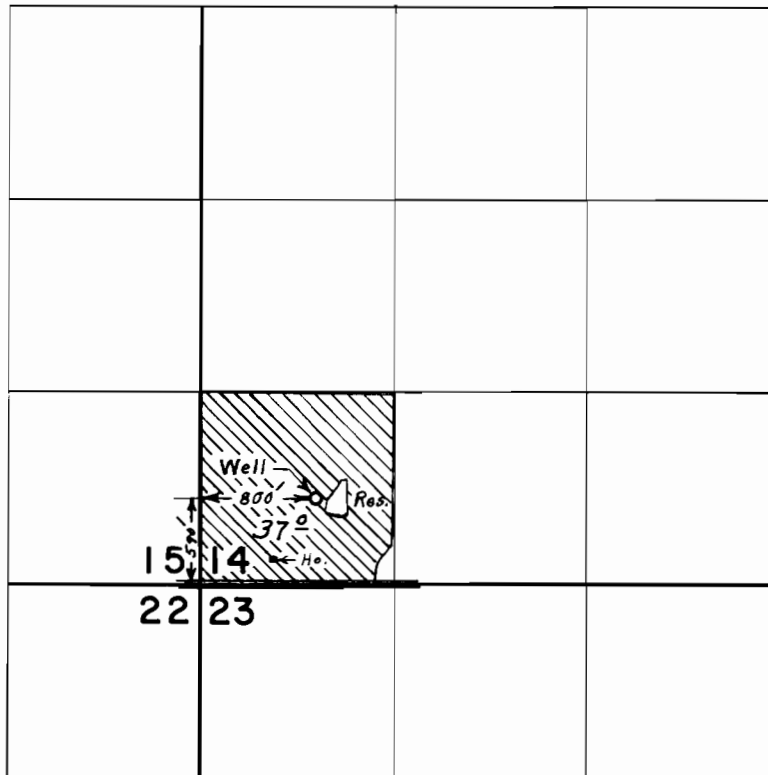

FINAL PROOF SURVEY
UNDER

Application No. G-6339 Permit No. G-5944
IN NAME OF

WILLIAM E. & SHIRLEY A. ALBEKE

Surveyed April 23, 1976, by L. E. Gould