


T.3 & 4 S. R.1 E. W.M.

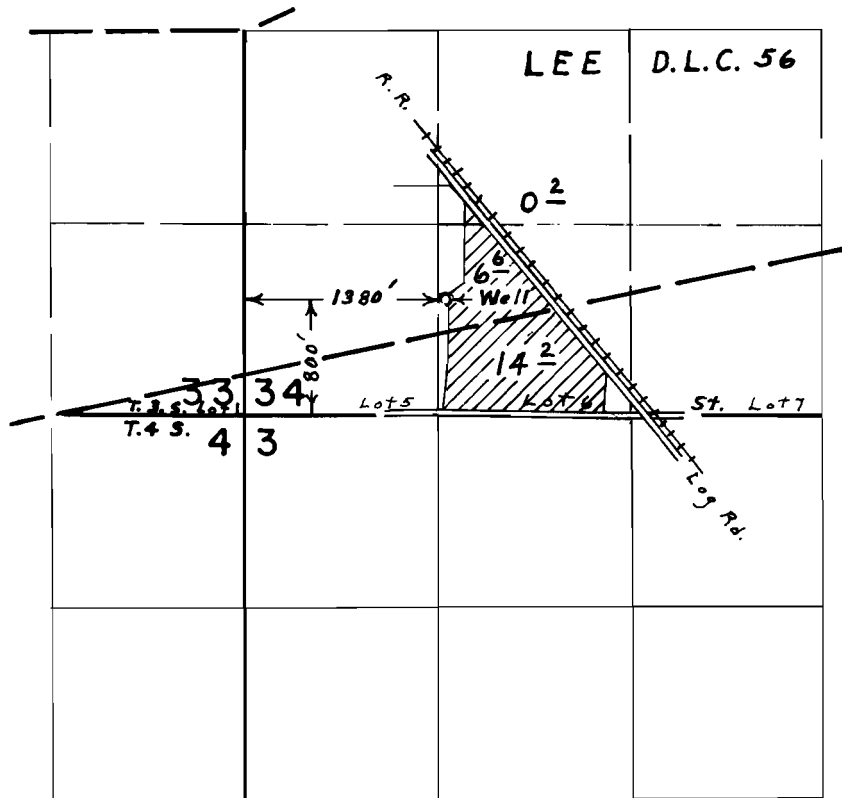

FINAL PROOF SURVEY UNDER

Application No. G-6954 Permit No. G-5695
IN NAME OF

DONALD HANSON

Surveyed April 21, 1976, by L. E. Gould.