


T.2S. R.3E. W.M.

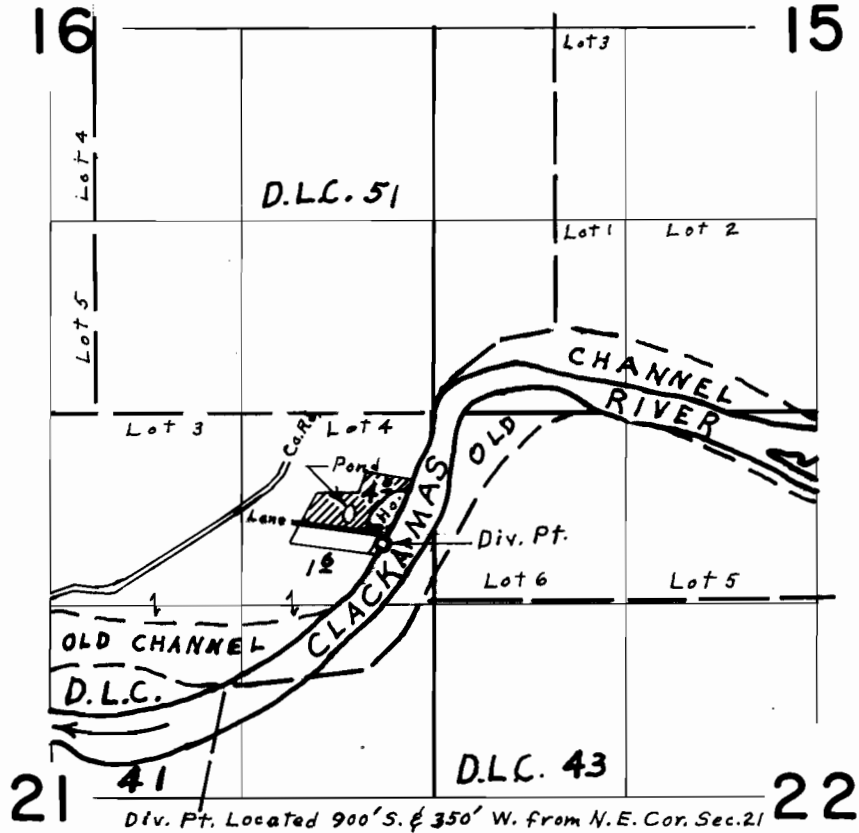

**FINAL PROOF SURVEY**  
UNDER

Application No. 39258 Permit No. 29242  
IN NAME OF

WALTER R. & PATRICIA A. ENDERS

Surveyed Oct. 8, 1976. by L. E. Gould