


# T.2 S. R.1 E. WM.

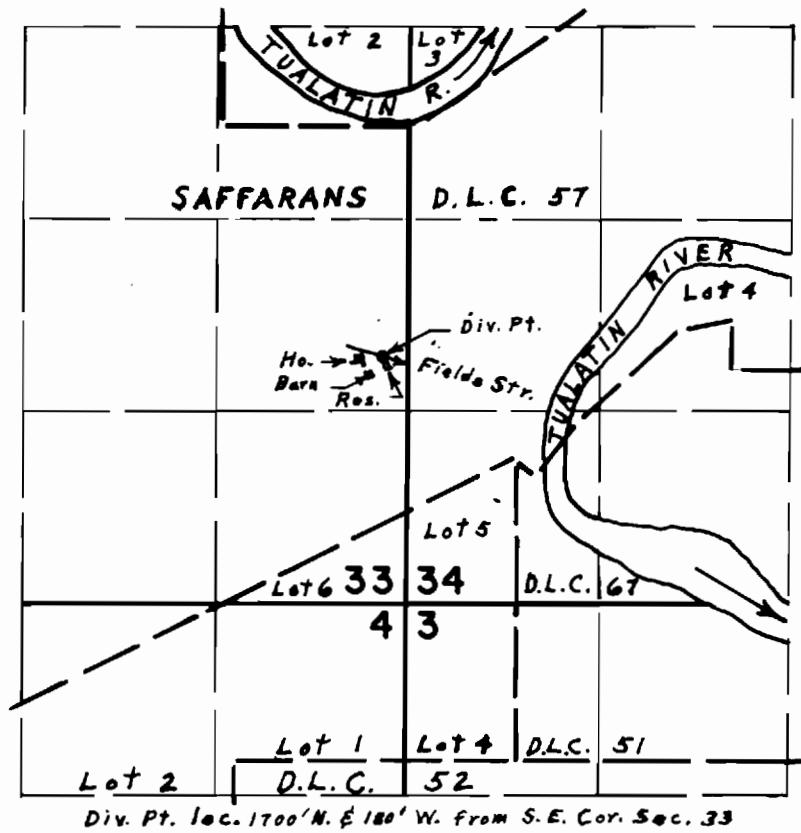

## FINAL PROOF SURVEY UNDER

R-49171                      R-5830  
 Application No. ~~48232~~... Permit No. ~~36043~~...  
 IN NAME OF

**JAMES R. MACKEN**

Surveyed June 2, 1976, by L. E. Gould