


T.2 S. R.1 E. WM.

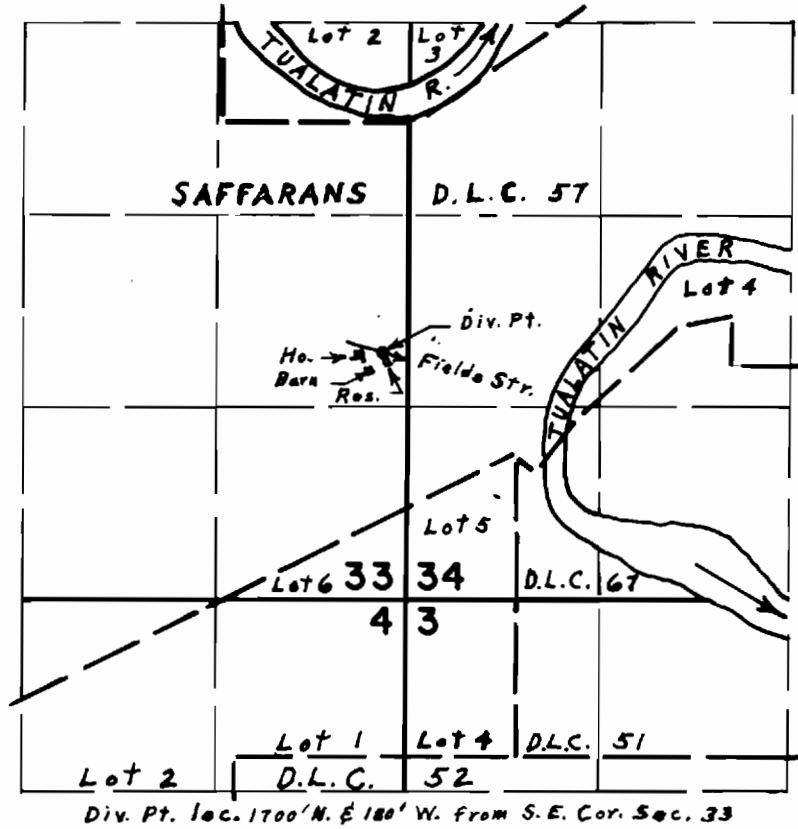

FINAL PROOF SURVEY UNDER

R-49171 R-5830
 Application No. 48232... Permit No. 36043...
 IN NAME OF

JAMES R. MACKEN

Surveyed June 2, 1976, by L. E. Gould