


T.5N., R.10W., W.M.

SEC. 4

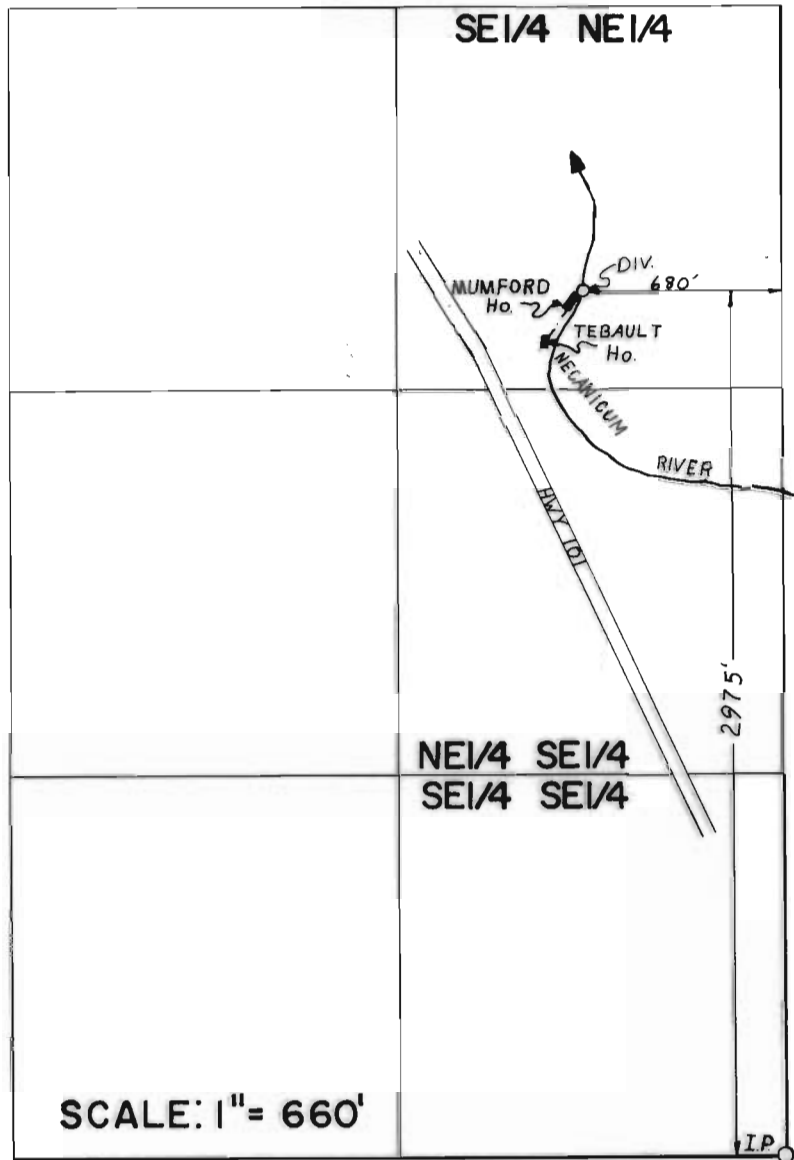

**FINAL PROOF SURVEY**  
UNDER

Application No. 51756 Permit No. 39002

IN NAME OF  
GERALD E. MUMFORD &  
ALFRED L. TEBAULT.

Surveyed SEPT. 16, 1976, by C.R. KING