


7250 5 1 1 8
T.4 N. R.10 W.W.M.

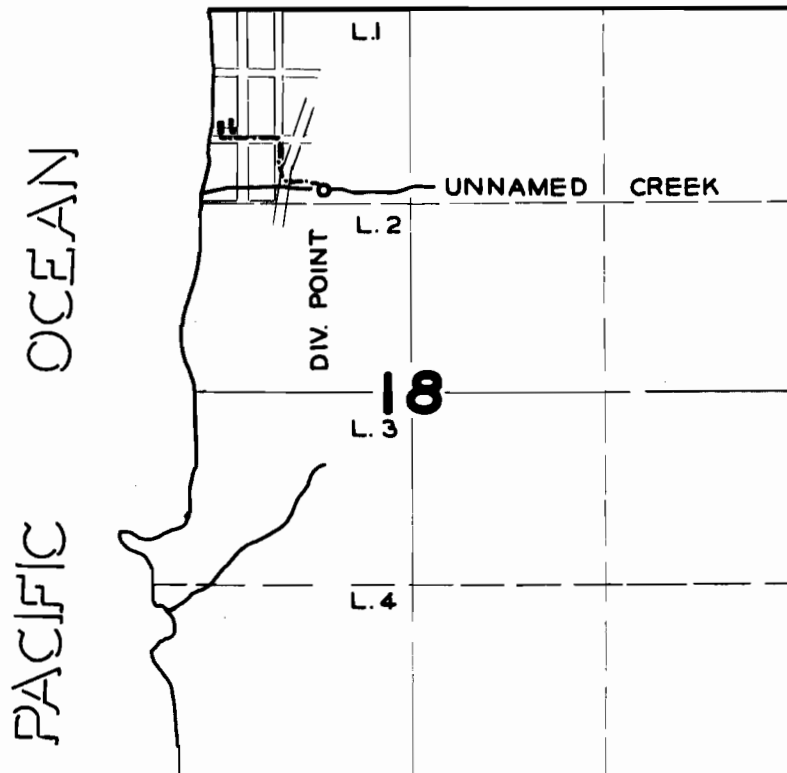

FINAL PROOF SURVEY
UNDER

Application No. 19259 Permit No. 14859
IN NAME OF

CHAS. V. PHILLIPS

Surveyed JULY 20 1950, by H.L. COFFMAN