


T. 36 S. R. 14 W. W.M.

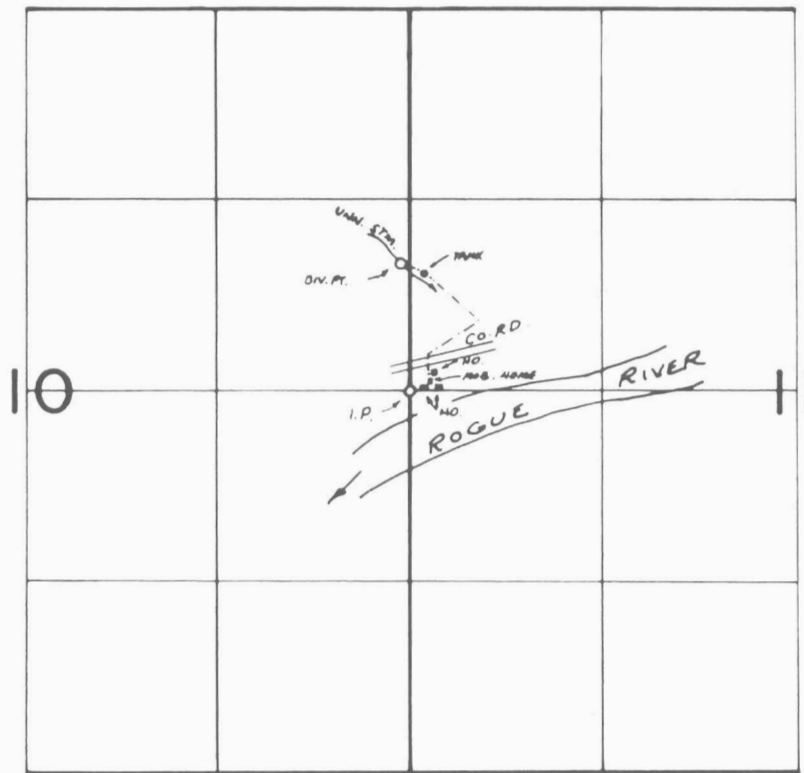

DIV. PT. LOCATED 870' N & 50' W FROM THE W 1/4 COR. SEC 11

FINAL PROOF SURVEY
UNDER

Application No. 49642... Permit No. 36106...
IN NAME OF

DALE & LYNNE GIOTTONINI

Surveyed OCT. 28 1977, by L. E. GOULD...