


T.41 S.R.13 W.W.M.

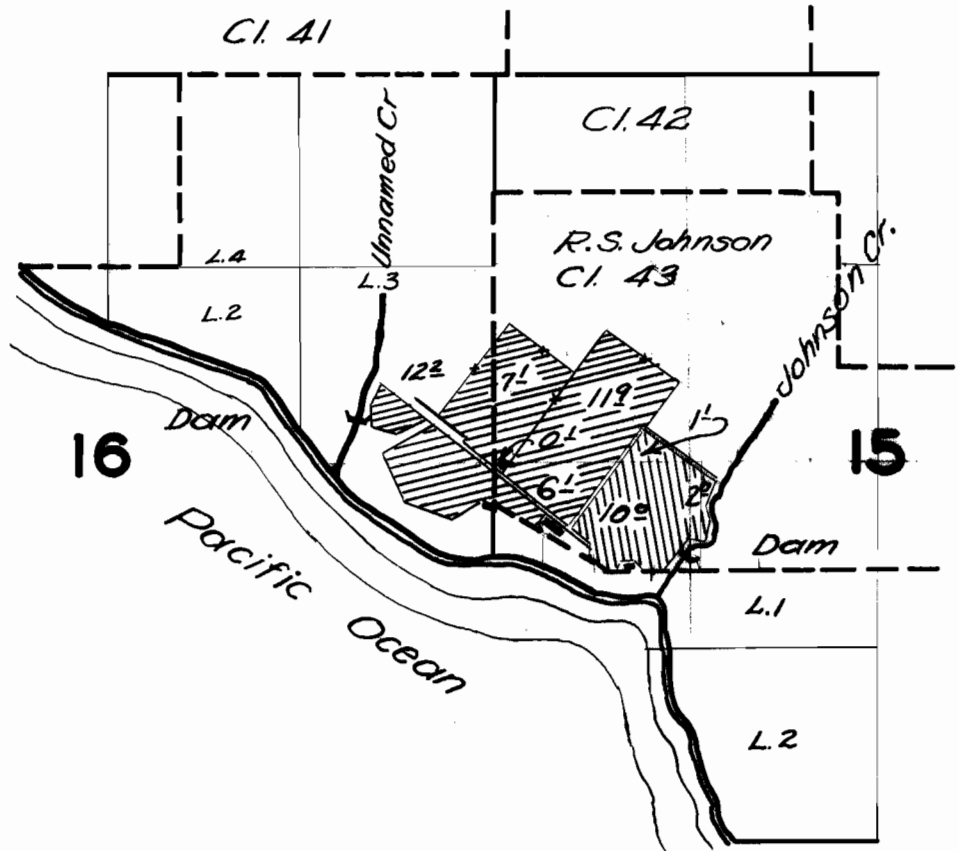

App. 24740 Permit 19506
 App. 25014 Permit 19709



FINAL PROOF SURVEY

UNDER

24740 19506

Application No. 25014 Permit No. 19709

IN NAME OF

Ray Springer and R.L. Oliver

A.K. Hastings

Surveyed Sept. 19, 1953, by H.L. Hoffman