


T.32&33S. R.6W. W.M.

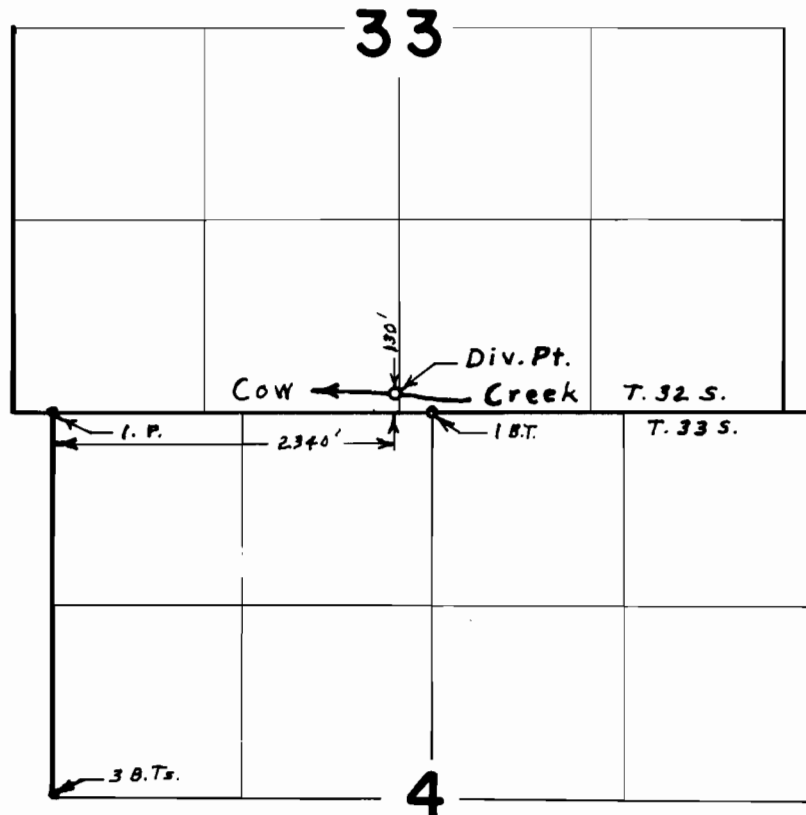

**FINAL PROOF SURVEY**  
UNDER

Application No. 50868 Permit No. 38407  
IN NAME OF

**CITY OF GLENDALE**

Surveyed April 13, 1976, by L. E. Gould

T. 32 S. R. 6 W. W.M.

Scale: 1" = 1320'

32

33

City of Glendale

5

4

T. 33 S. R. 6 W. W.M.

P.O.D. located 40' N. &  
2720' W From the S.E. Corner  
of Sec. 33, T. 32 S. R. 6 W. W.M.

RECEIVED

OCT 15 1973

PLANT ENGINEER  
LOSEM, OREGON

Application No. 50868

Permit No. 38407