


T.29 S. R.5 W. W.M.

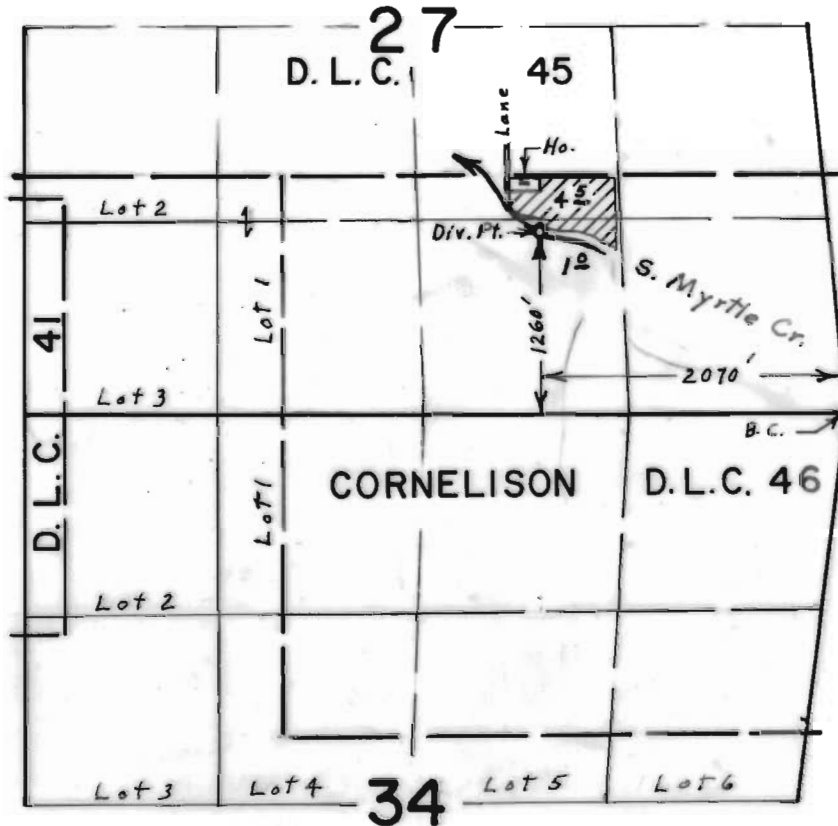

FINAL PROOF SURVEY
UNDER

Application No. 50917... Permit No. 38442...
IN NAME OF

AUGUST H. & ROSE E. JANNSEN

Surveyed May 11, 1976, by L. E. Gould