


**T.22S.R.9W.W.M.**

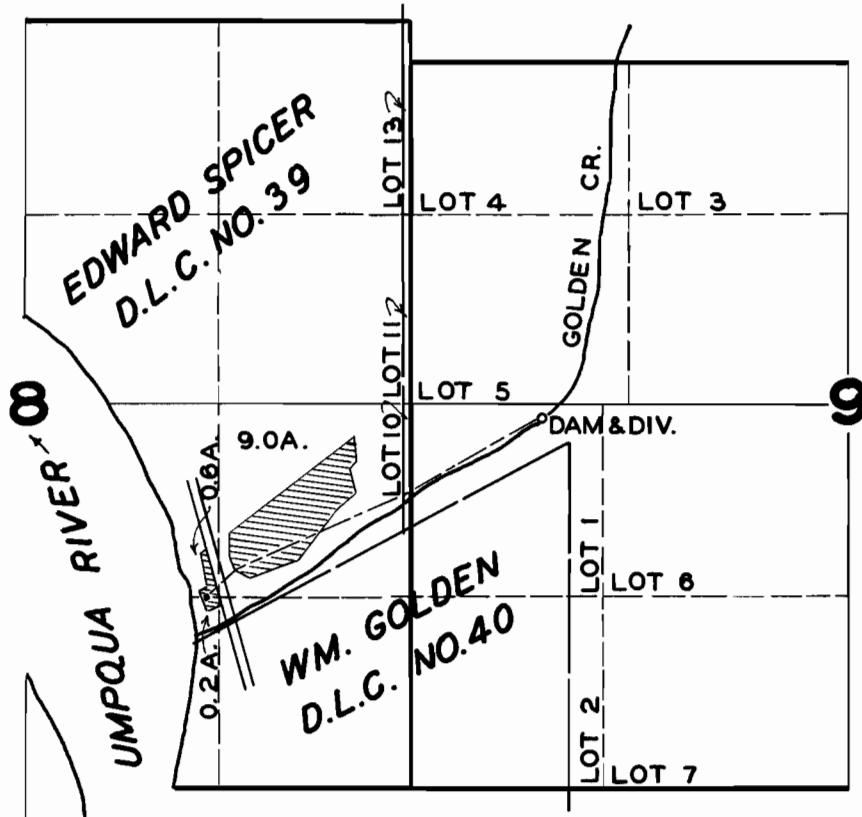

**FINAL PROOF SURVEY**

UNDER

**R-18968**

**R-754**

Application No. **18969** Permit No. **14566**

IN NAME OF

**ARCHIE C. LOUD**

Surveyed **JULY 13, 1948**, by **JAS. E. BUNNELL**