


T.37S. R.4&5W. W.M.

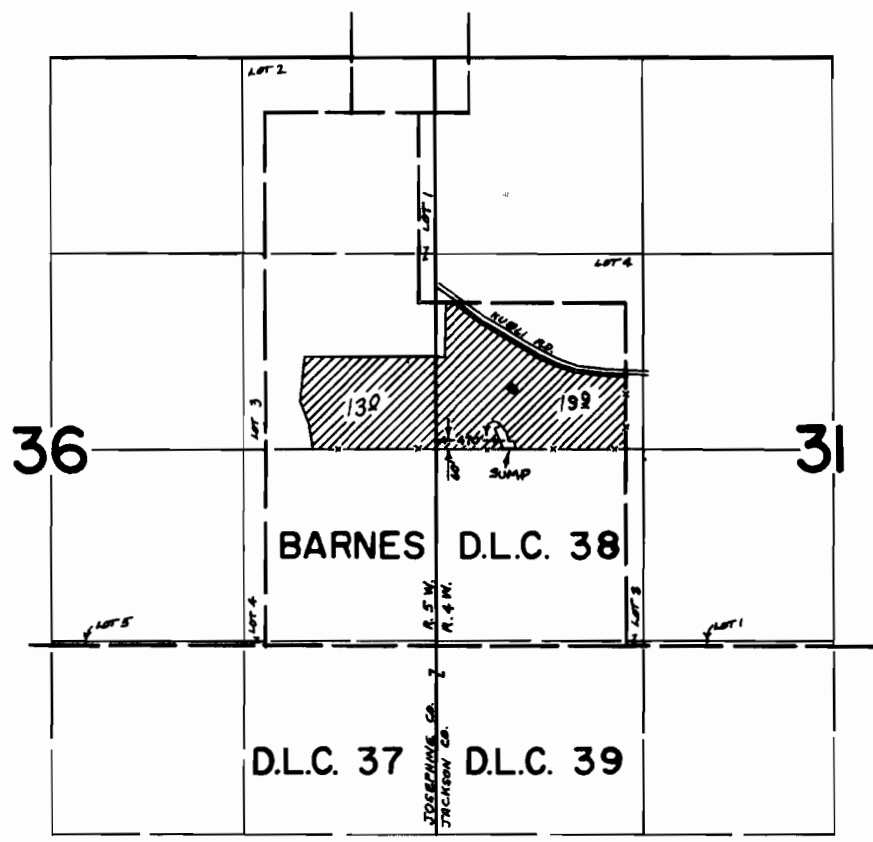

FINAL PROOF SURVEY
UNDER

Application No. G-4757 Permit No. G-4481
IN NAME OF

FRANCO VOLI

Surveyed NOV. 4, 1975, by L. TOLL