


T.38S.,R.3W.,W.M.

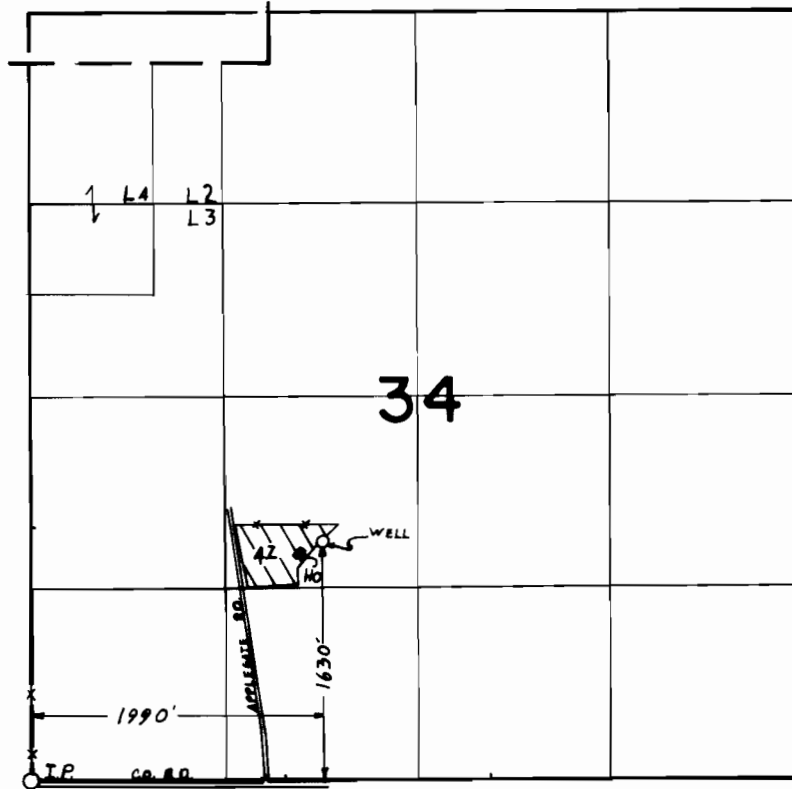

**FINAL PROOF SURVEY**  
UNDER

Application No. G-5919 Permit No. G-5627  
IN NAME OF

EDMUND & ELEANOR P. RAMSAY

Surveyed MAY 3 1976, by G.R. KING