


T.38S.,R.3W.,W.M.

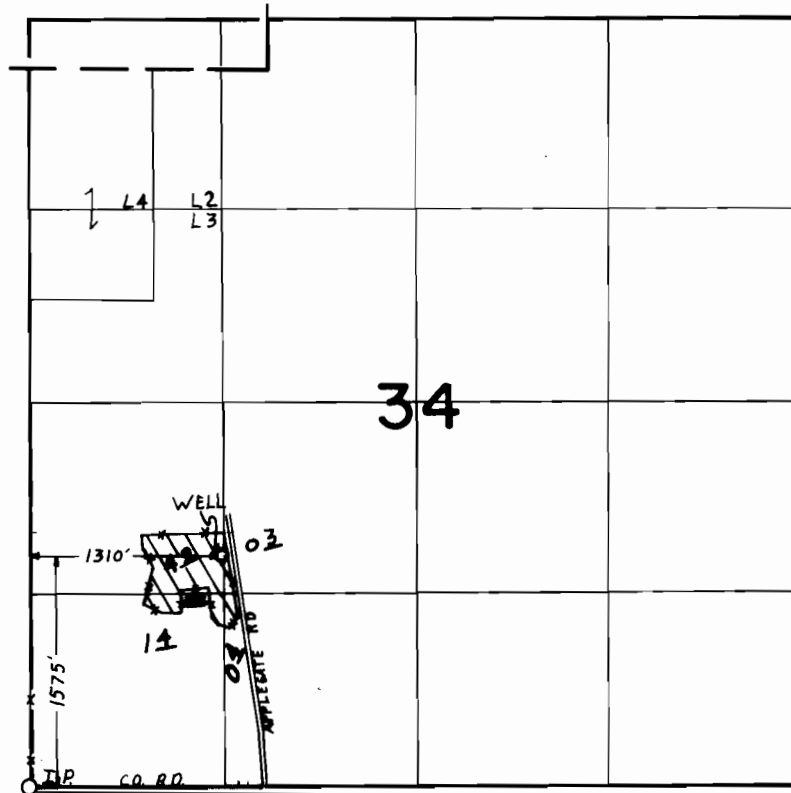

FINAL PROOF SURVEY
UNDER

Application No. G-5927 Permit No. G-5634
IN NAME OF

BRENICK J. O'DAY

Surveyed MAY 3 1976, by C.R. KING