


T.35S., R.4W., W.M.

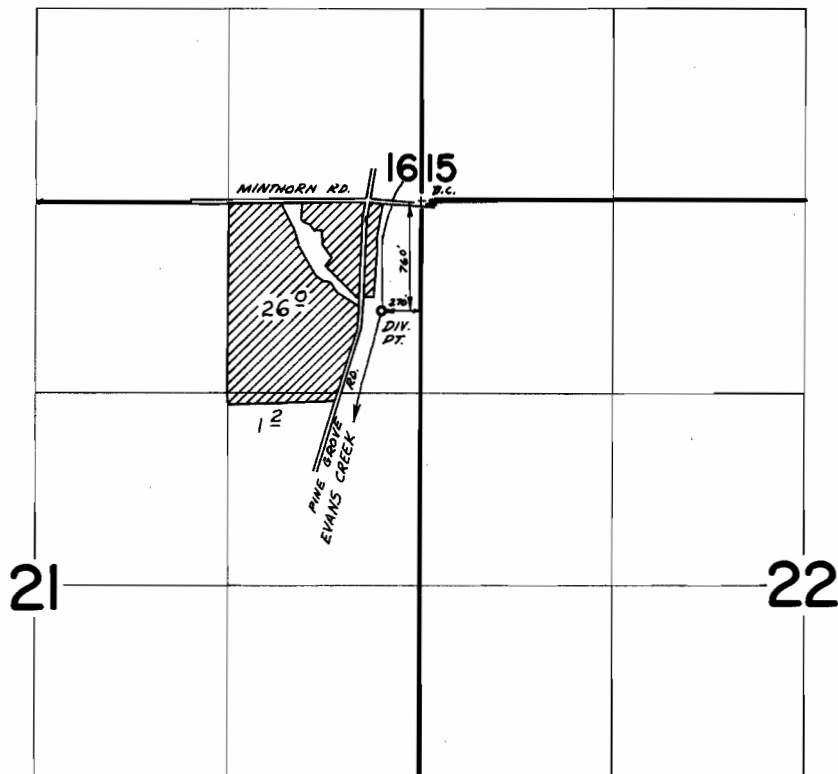

FINAL PROOF SURVEY
UNDER

Application No. 42871 Permit No. 32042
IN NAME OF
MELVIN MEAD

Surveyed Aug. 27, 1975, by D. Norby