


T.40S.,R.3W.,W.M.

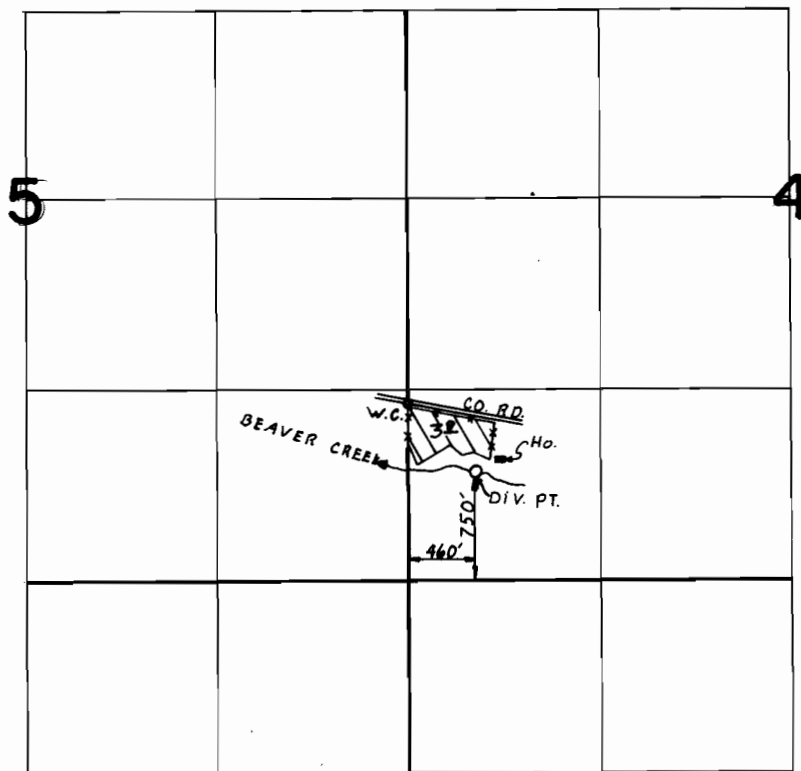

FINAL PROOF SURVEY
UNDER

Application No. 47119 Permit No. 35282
IN NAME OF

JOSEPH P. BRADSHAW

Surveyed MAY...6.. 1976., by C.R. KING.....